


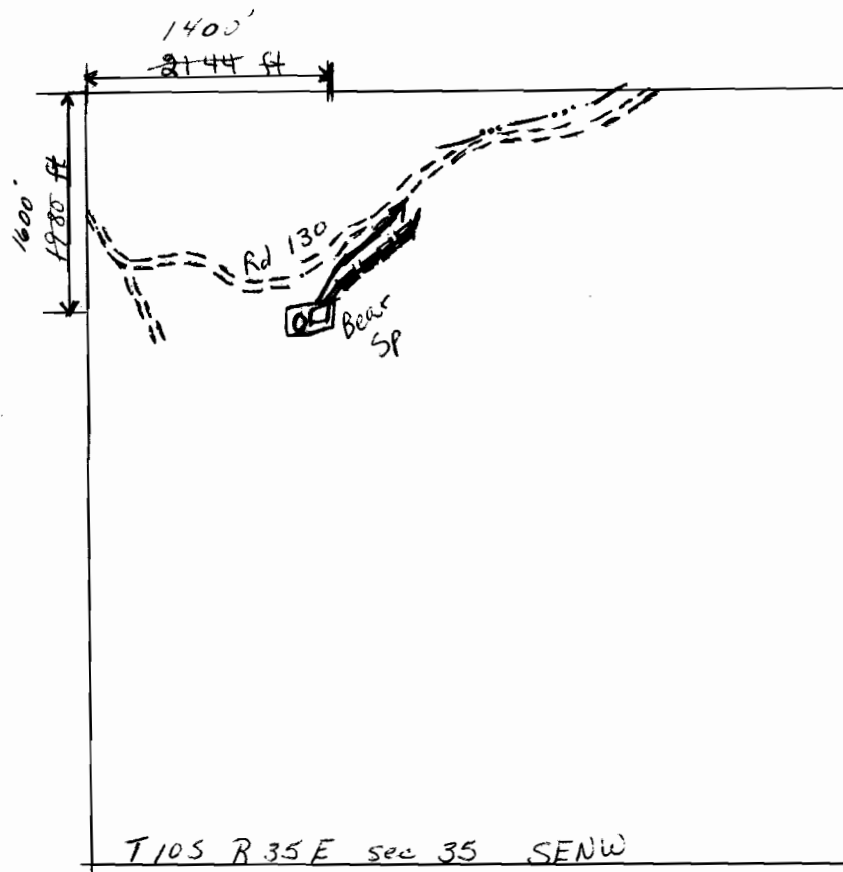

4 INCHES = 1 MILE



Application No. 64222
Permit No. 49066

RECEIVED

JUN 24 1983

WATER RESOURCES DEPT.
SALEM, OREGON

RECEIVED

SEP 29 1982

WATER RESOURCES DEPT.
SALEM, OREGON