

RECEIVED


JUN 24 1983

WATER RESOURCES DEPT.
SALEM, OREGON

RECEIVED

SEP 29 1982

WATER RESOURCES DEPT.
SALEM, OREGON

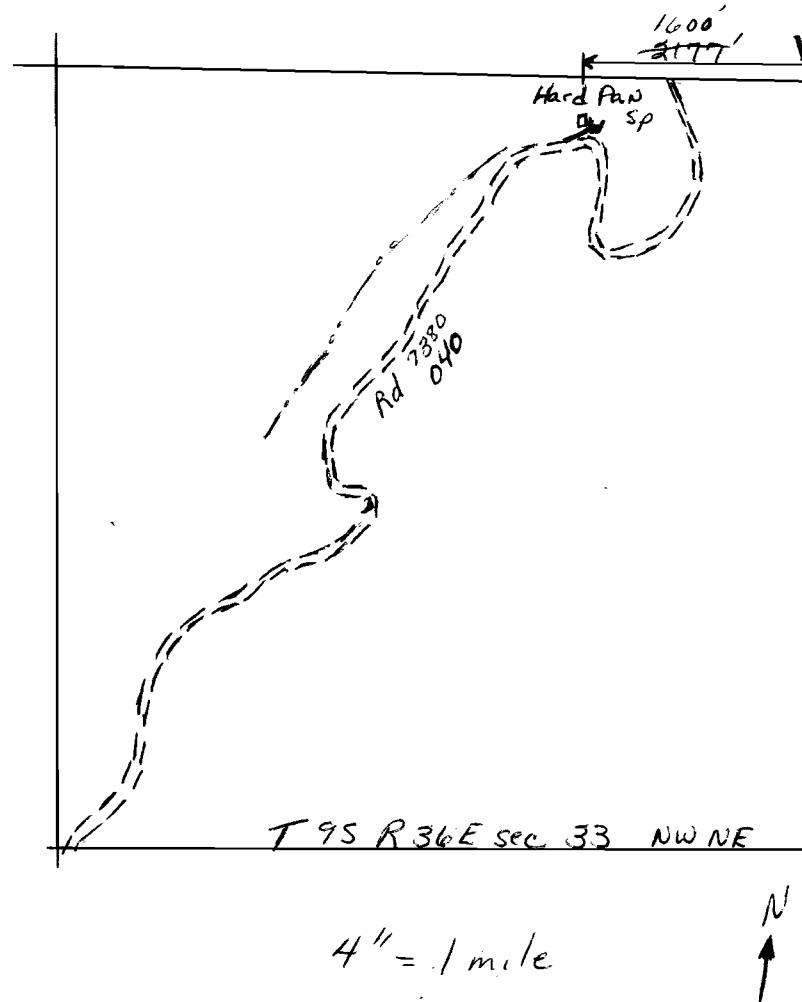

Application No. 64223
Permit No. 49067