


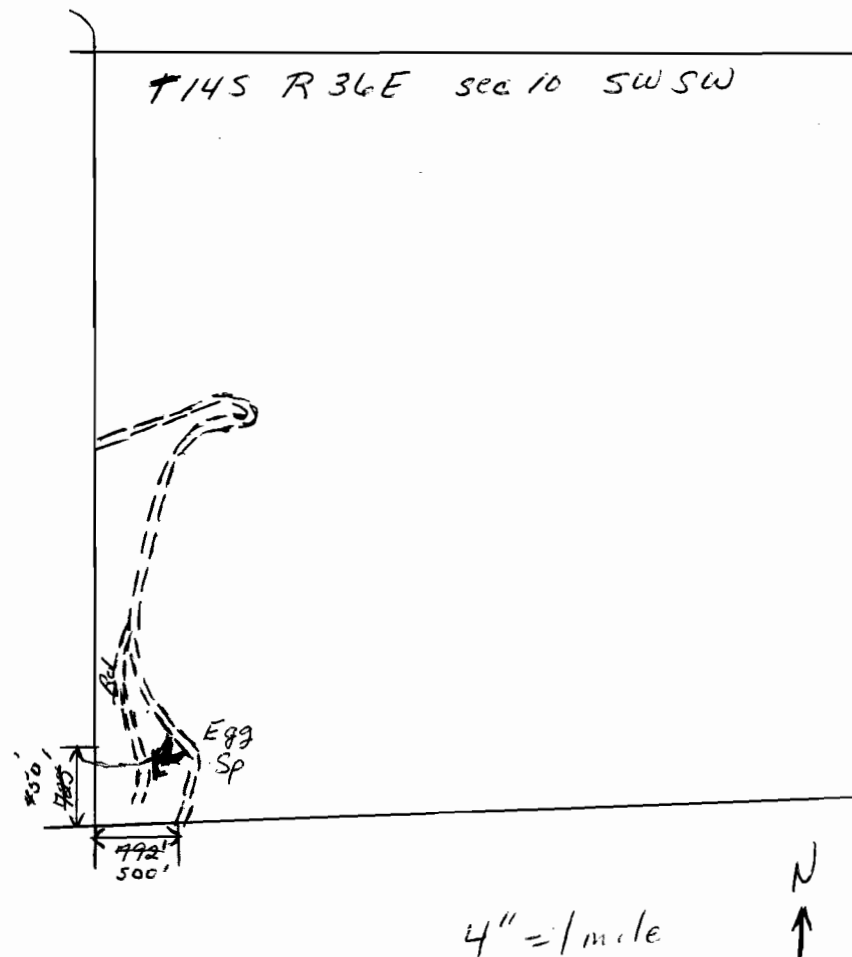

RECEIVED

SEP 29 1982

WATER RESOURCES DEPT.
SALEM, OREGON

RECEIVED

JUN 24 1983

WATER RESOURCES DEPT.
SALEM, OREGON

Application No. 64224
Permit No. 49068