


T11S R36E Sec 16

Application No. 64226
Permit No. 49070

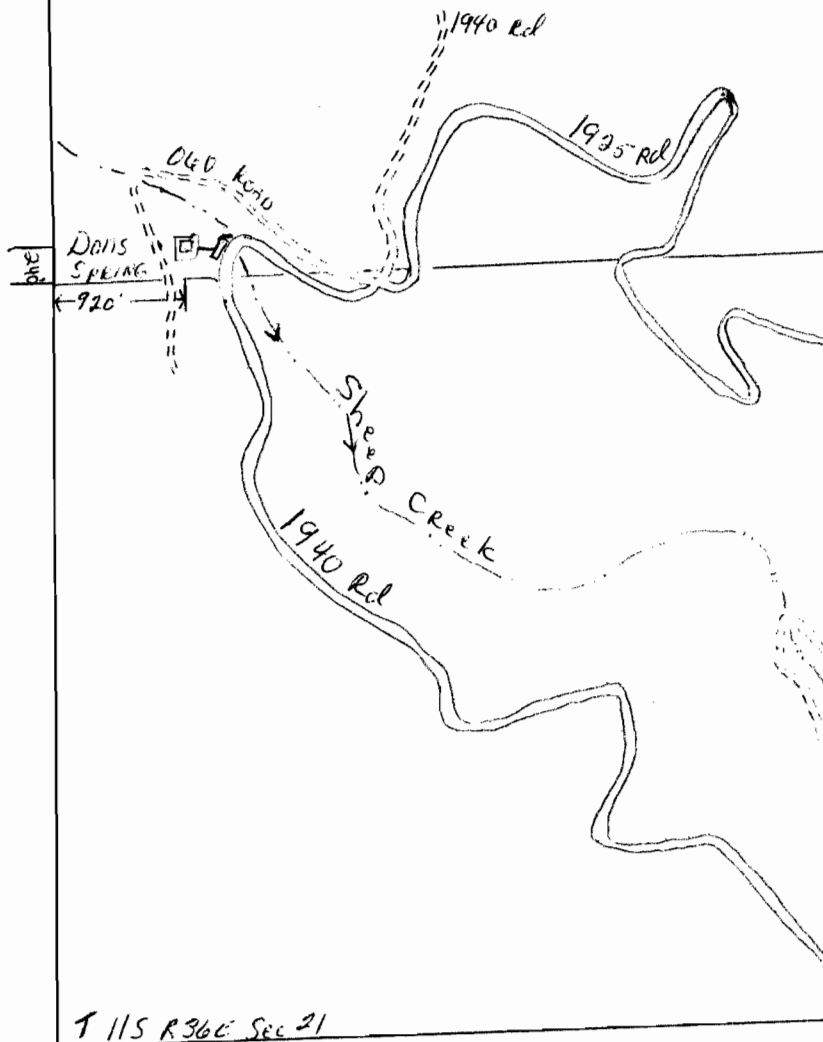

4" = 1 mile



RECEIVED

SEP 29 1982

WATER RESOURCES DEPT.
SALEM, OREGON