


Application No. 64227
Permit No. 49071

RECEIVED
SEP 29 1982
WATER RESOURCES DEPT.
SALEM, OREGON

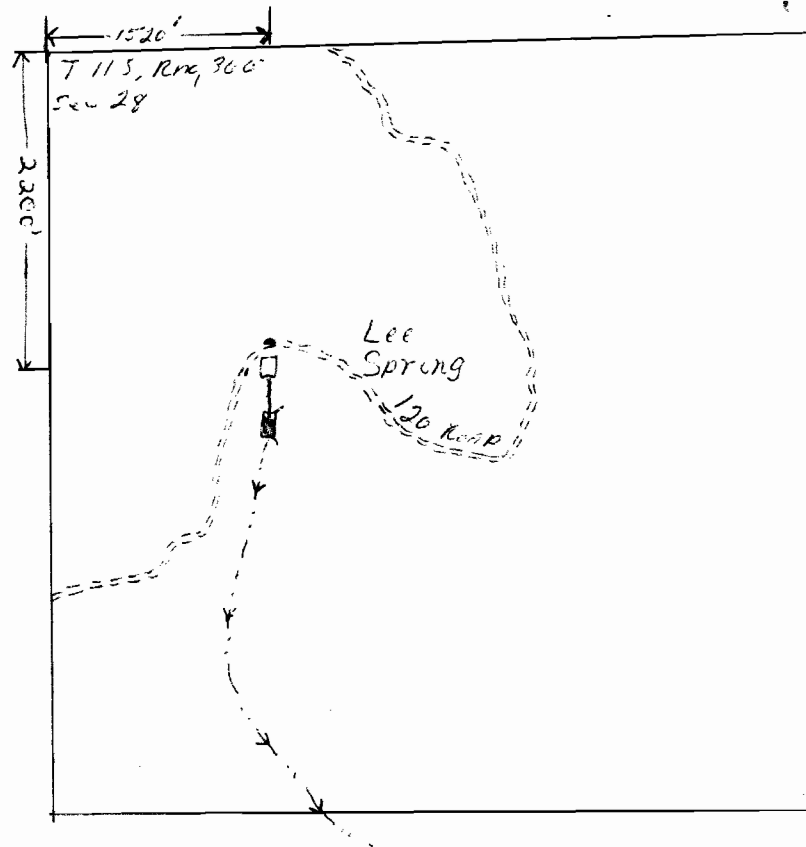

4" = 1 mile

