


RECEIVED

SEP 29 1982

WATER RESOURCES DEPT.
SALEM, OREGON

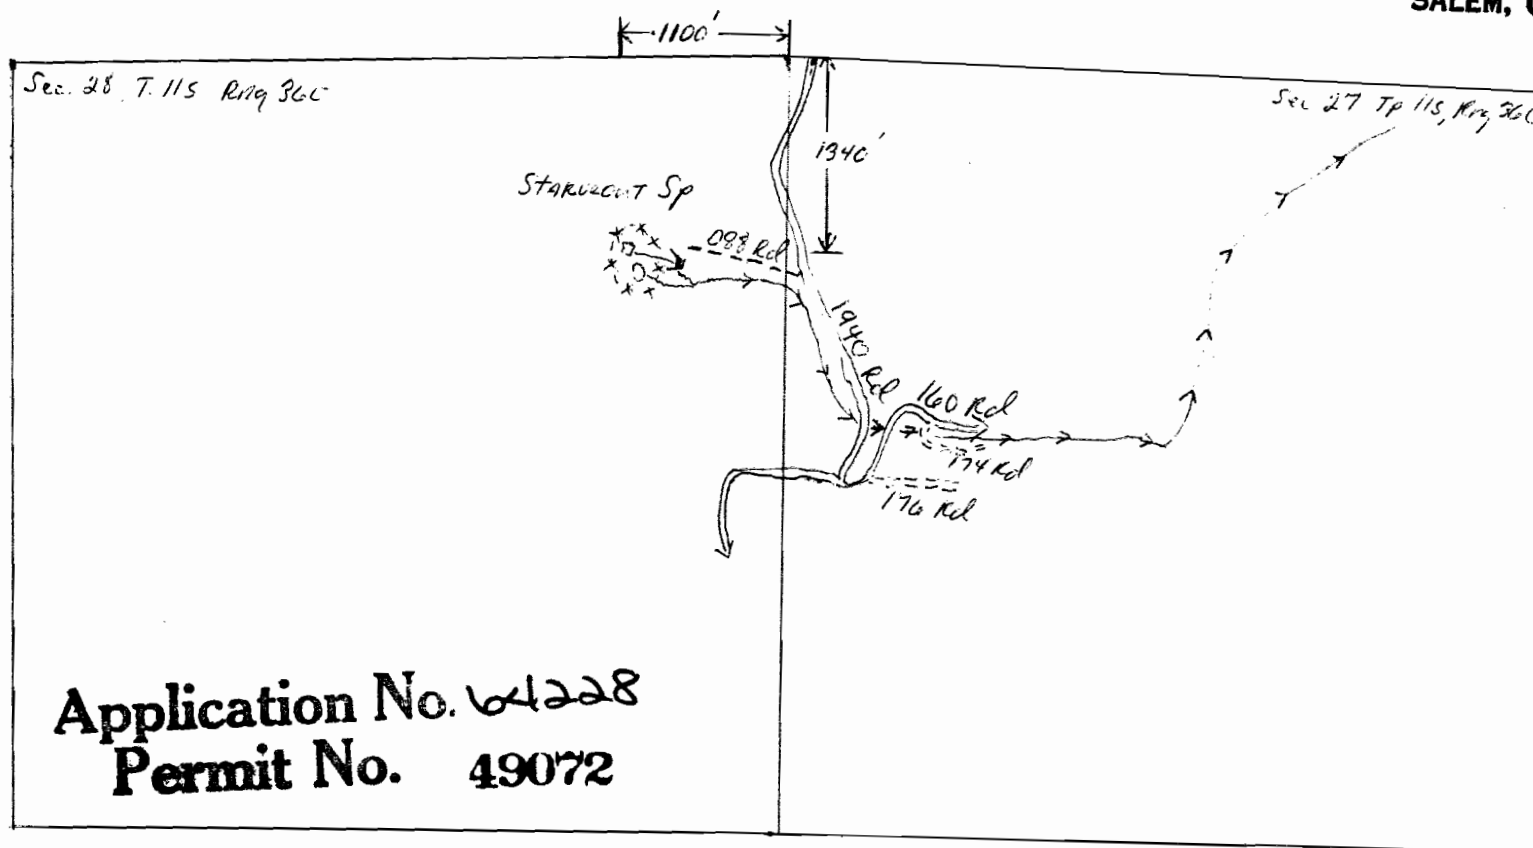

4" = 1 mile

