


Application No. 64229
Permit No. 49073

RECEIVED
SEP 29 1982
WATER RESOURCES DEPT.
SALEM, OREGON

RECEIVED
JUN 24 1983
WATER RESOURCES DEPT.
SALEM, OREGON

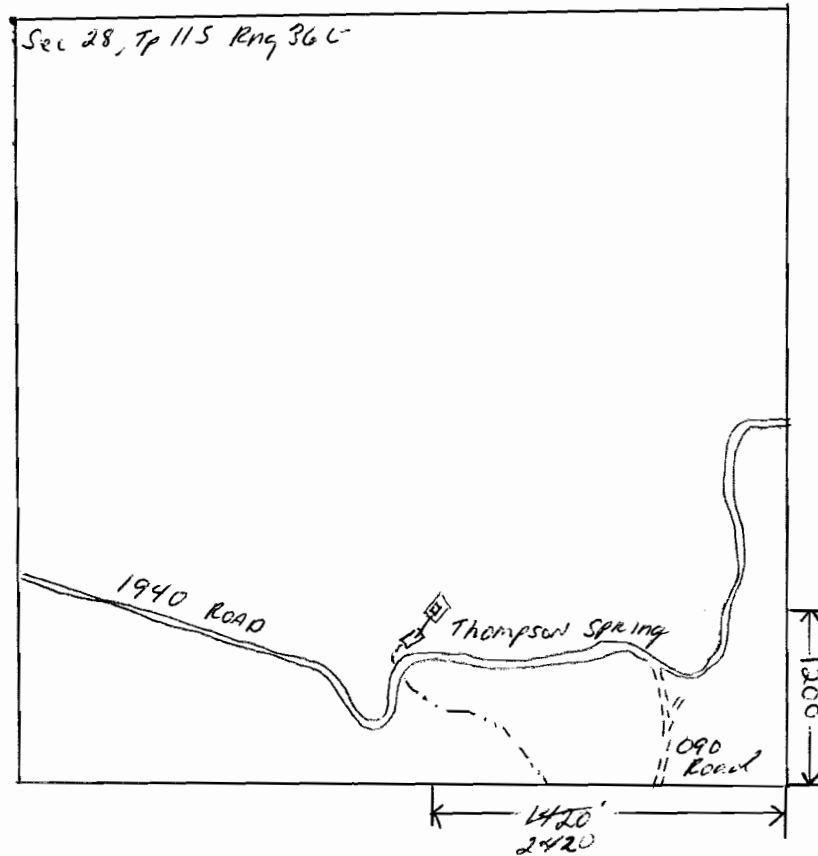

4" = 1 mile

N↑