


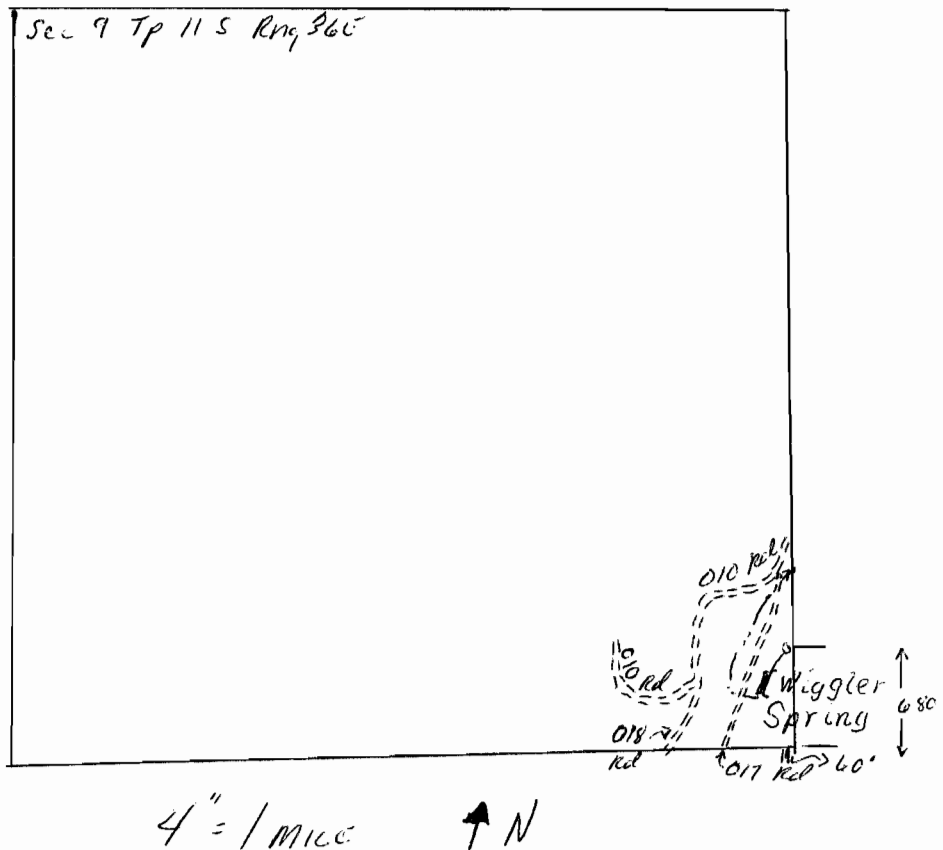

Application No. 64230
Permit No. 49074

RECEIVED
SEP 29 1982
WATER RESOURCES DEPT.
SALEM, OREGON