


Application No. 64231
Permit No. 49075

Subdivided
6/6/05
LHN

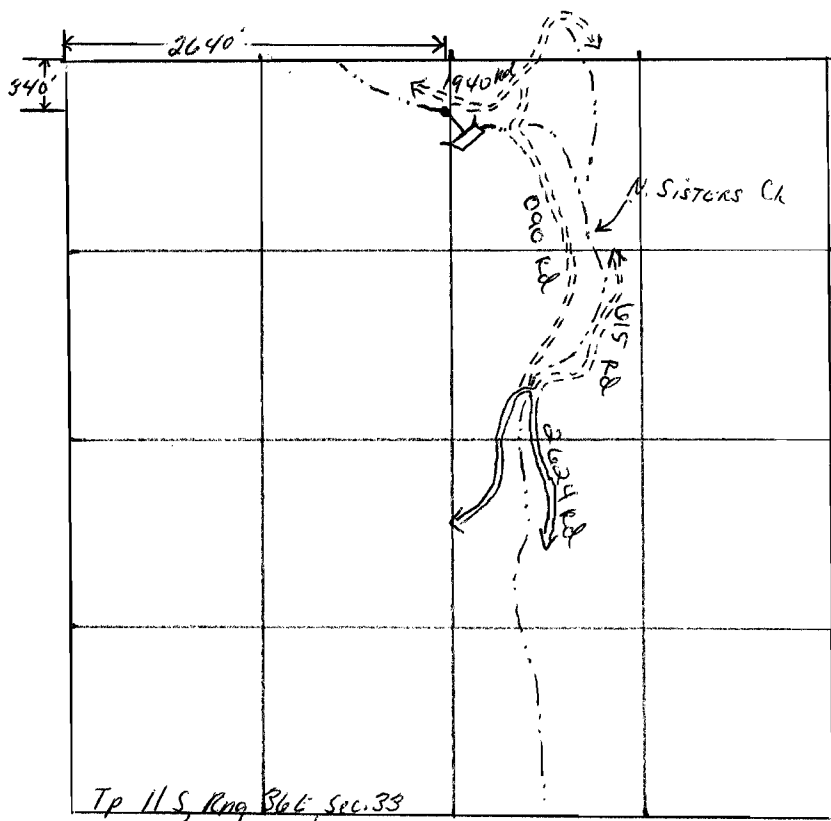

4" = 1 MILE

↑ N

RECEIVED
SEP 29 1982
WATER RESOURCES DEPT.
SALEM, OREGON