


Application No. 64232
Permit No. 49076

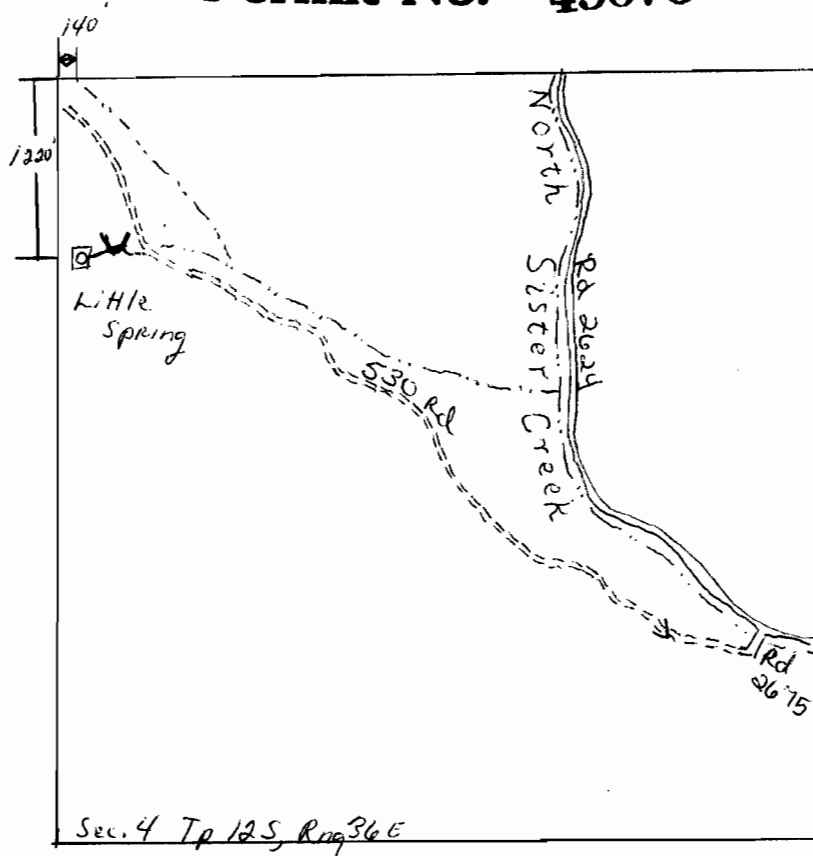

4" = 1 mile ↑ N

RECEIVED
SEP 29 1982
WATER RESOURCES DEPT.
SALEM, OREGON