


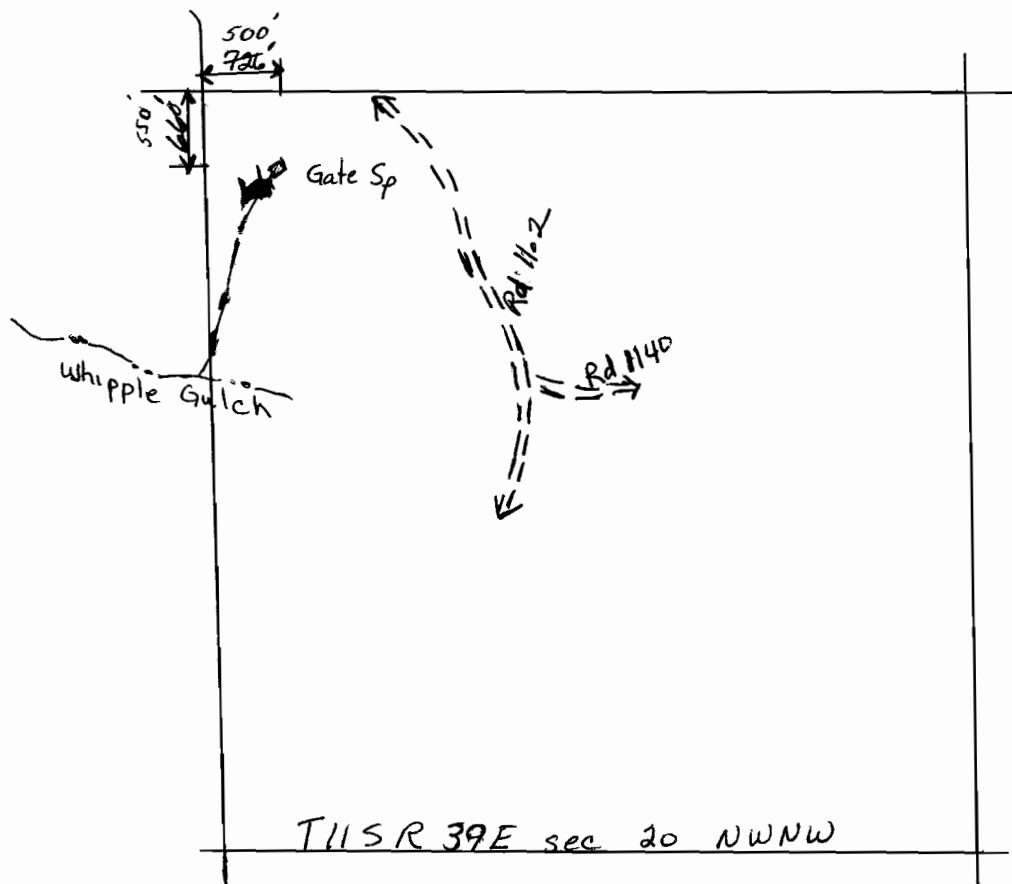

RECEIVED
 JUN 24 1983
 WATER RESOURCES DEPT.
 SALEM, OREGON

RECEIVED
 SEP 29 1982
 WATER RESOURCES DEPT.
 SALEM, OREGON

4" = 1 mile



Application No. 64233
Permit No. 49077