


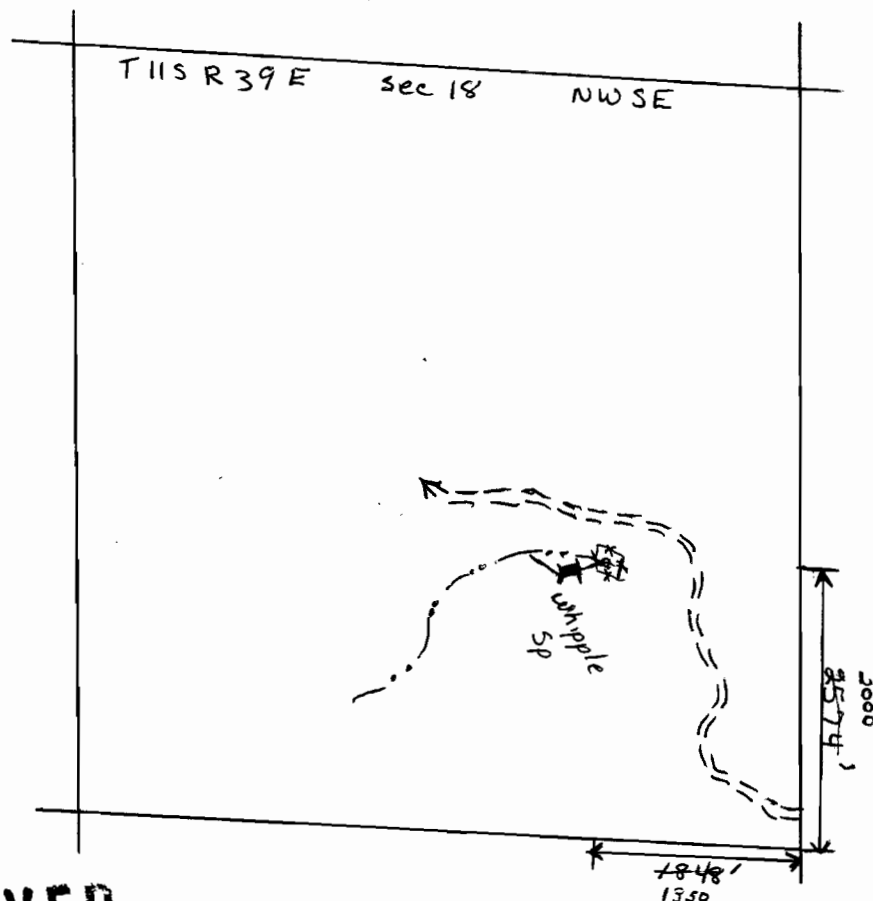

RECEIVED
SEP 29 1982
WATER RESOURCES DEPT.
SALEM, OREGON

RECEIVED
JUN 24 1983
WATER RESOURCES DEPT.
SALEM, OREGON

4" = 1 mile

Application No. 64234
Permit No. 49078