


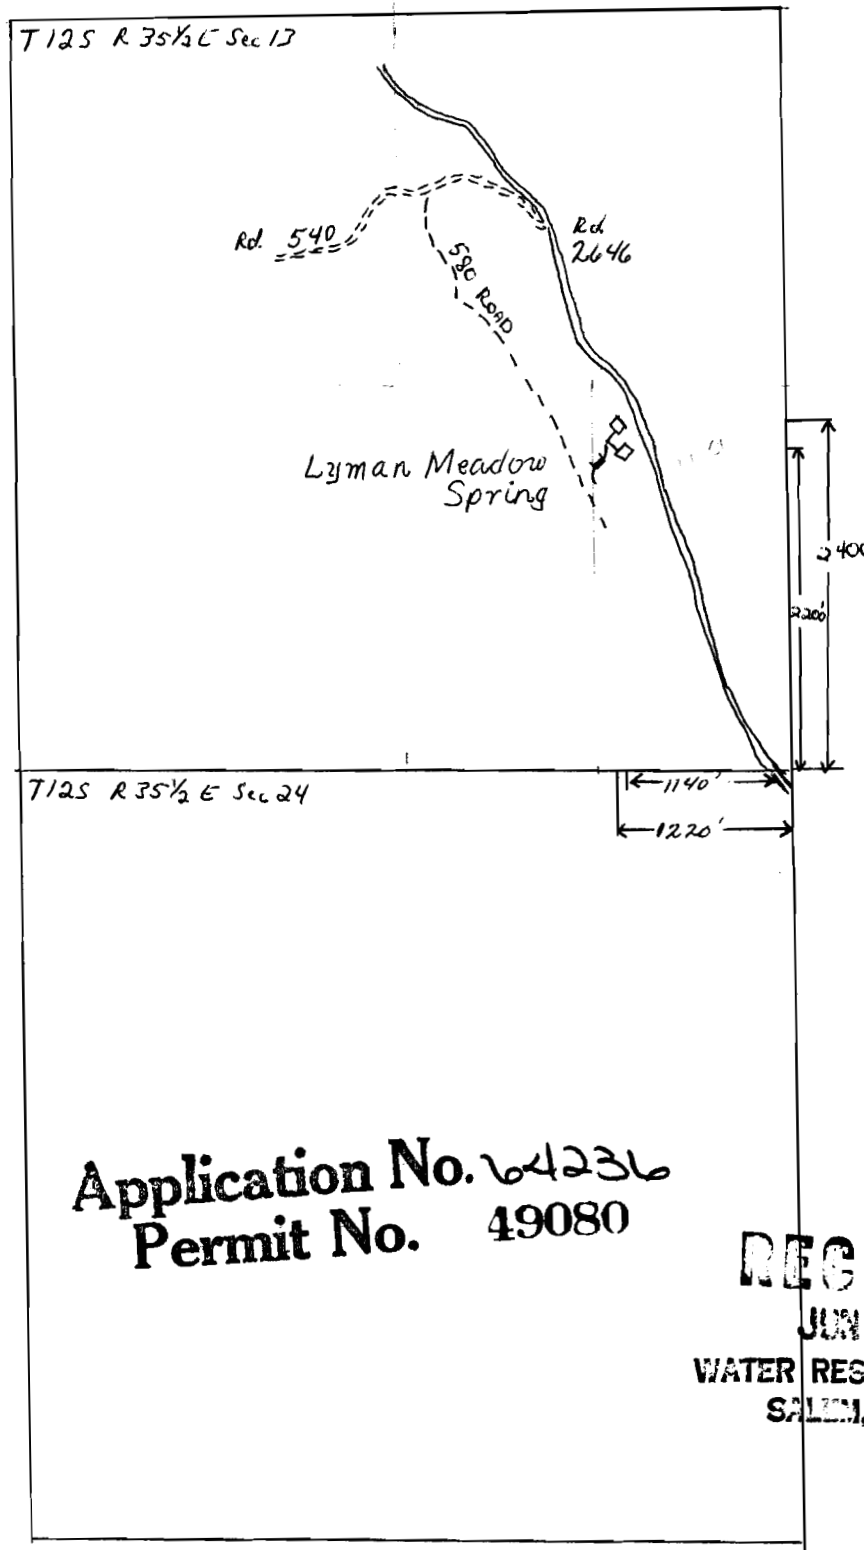

4" = 1 MILE

N ↑

RECEIVED

JUN 24 1983

WATER RESOURCES DEPT.
SALEM, OREGON

RECEIVED

SEP 29 1982

WATER RESOURCES DEPT.
SALEM, OREGON