


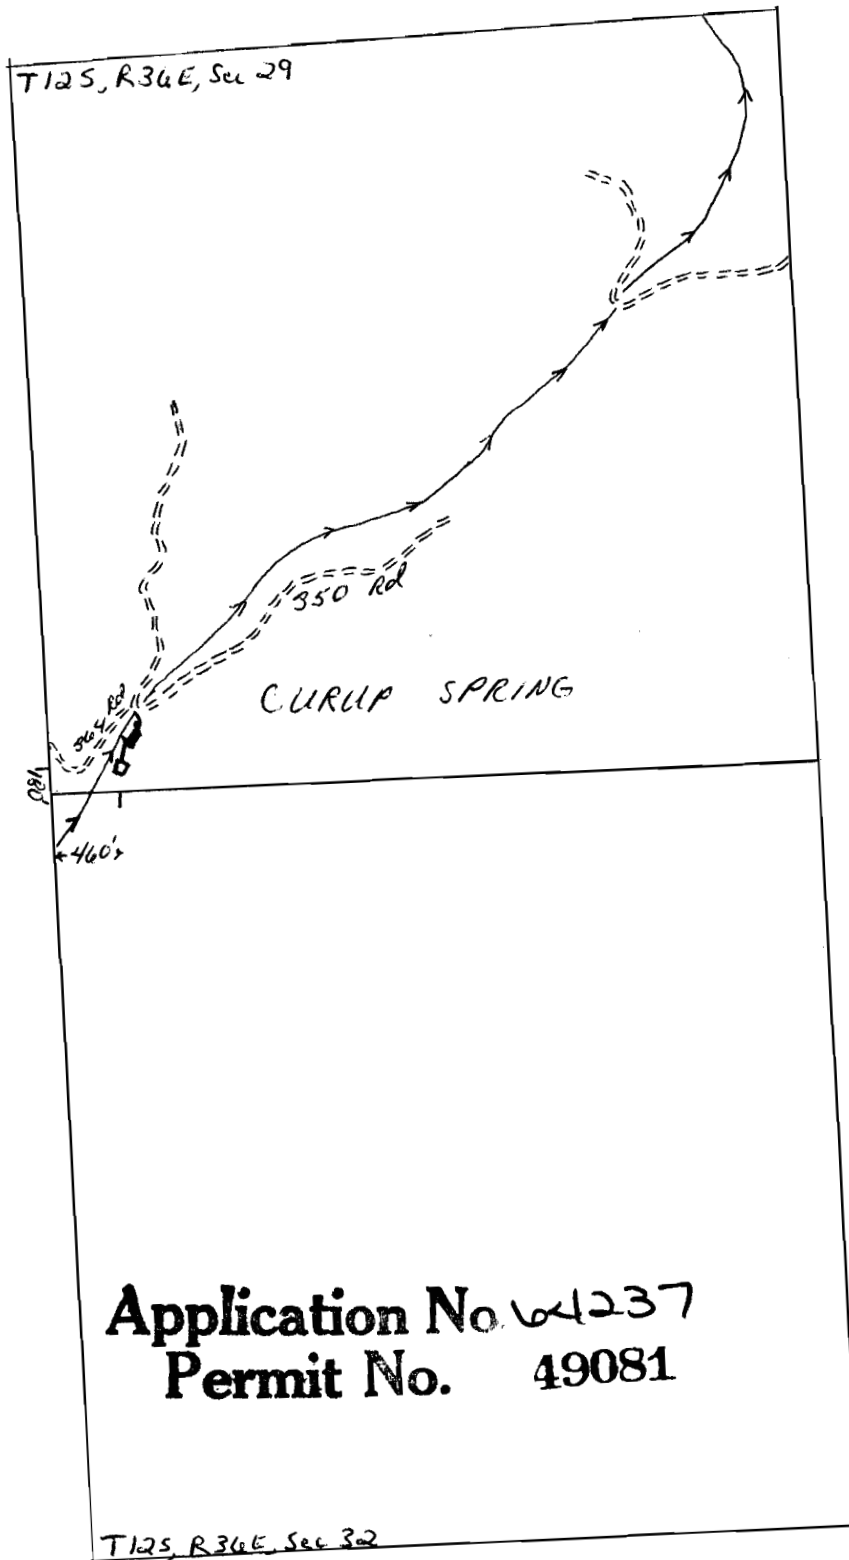

RECEIVED

SEP 29 1982

WATER RESOURCES DEPT.
SALEM, OREGON

4" = 1 MILE

N ↑