


Application No. 64239
Permit No. 49083

RECEIVED
SEP 29 1982
WATER RESOURCES DEPT.
SALEM, OREGON

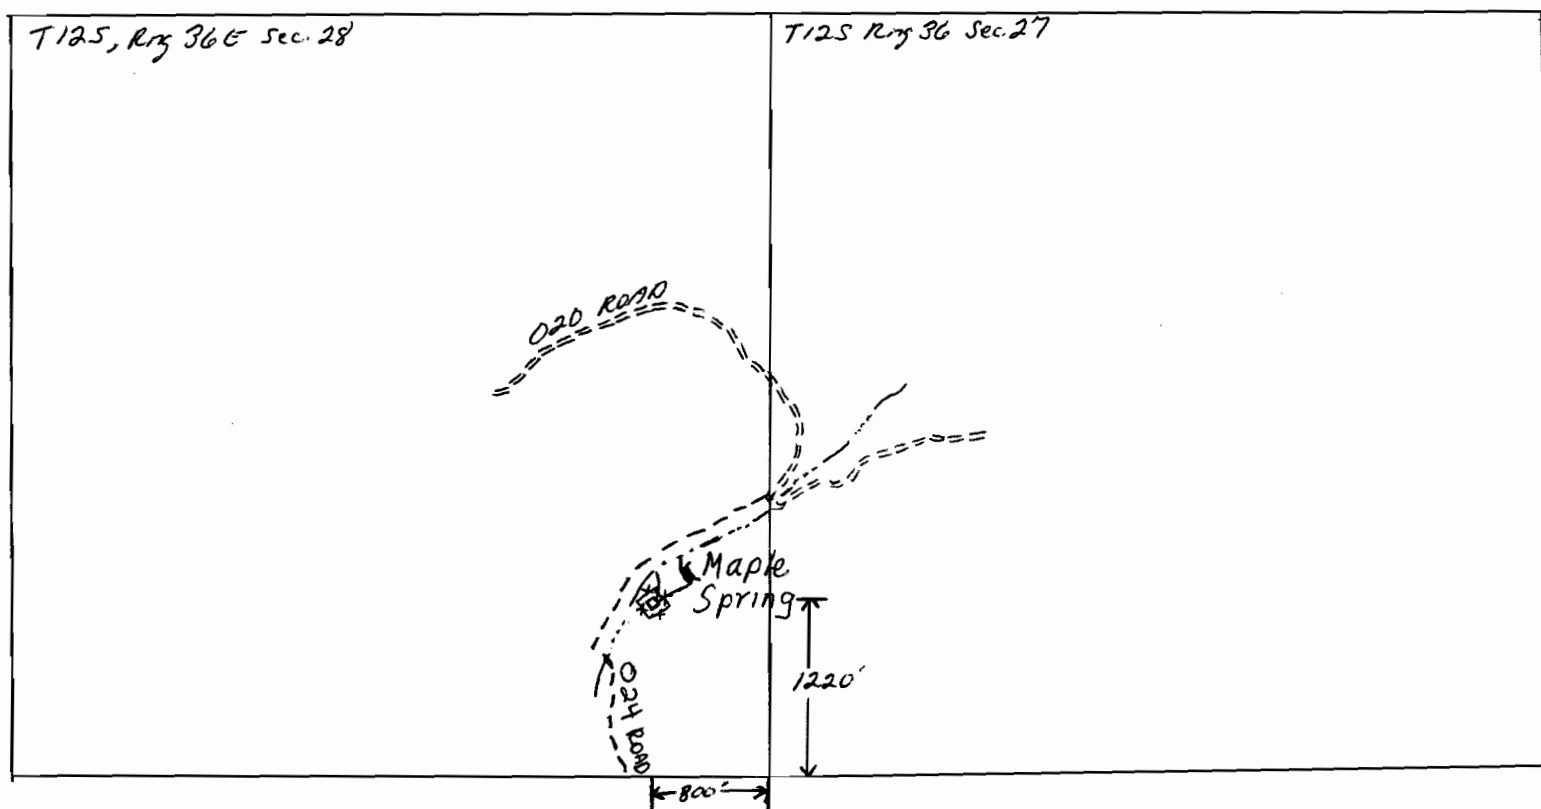

4" = 1 MILE

