


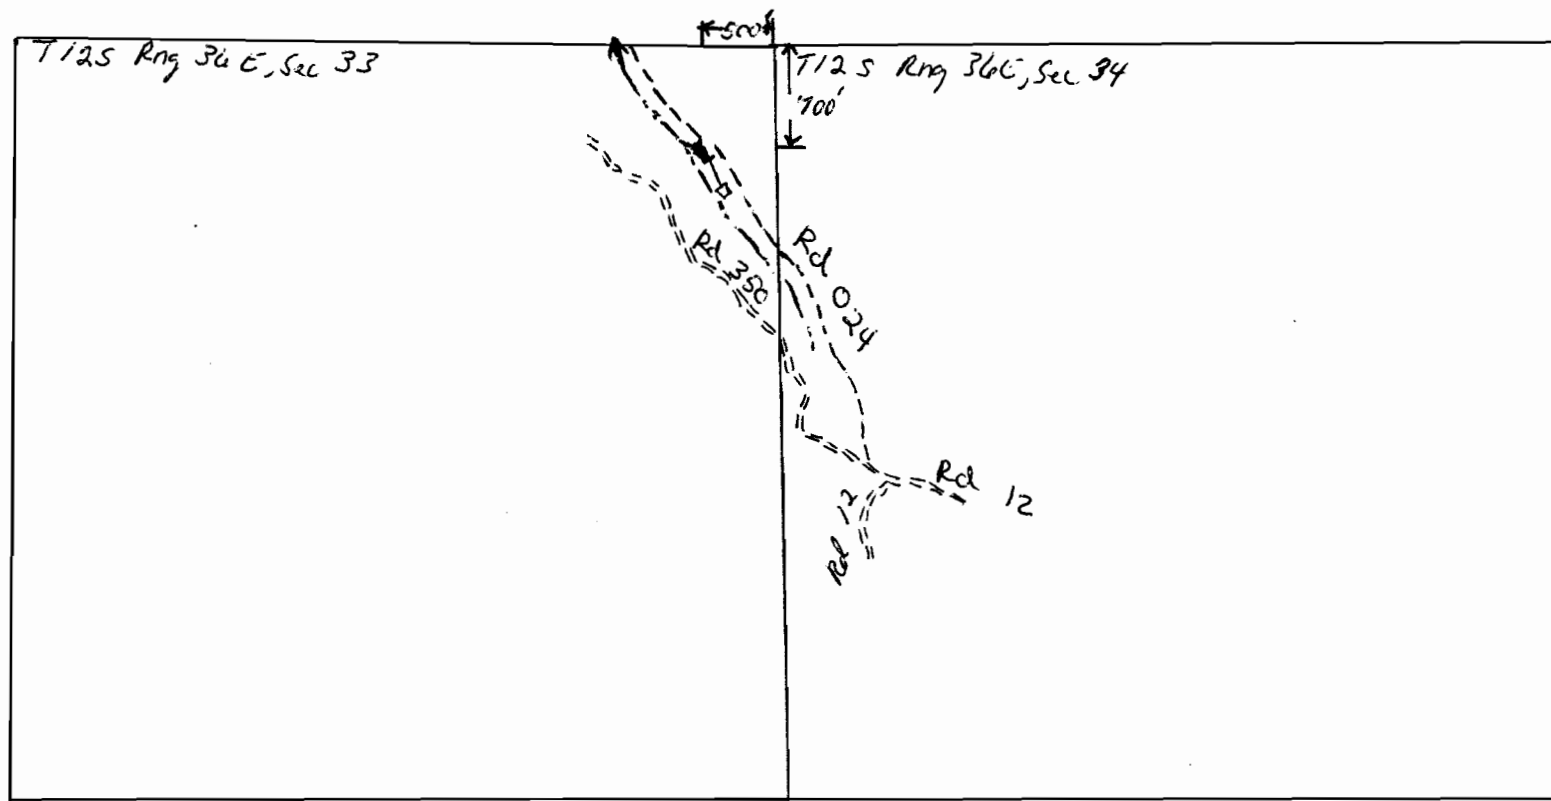

RECEIVED

SEP 29 1982

WATER RESOURCES DEPT.
SALEM, OREGON



Application No. 64240
Permit No. 49084