


Application No. 64241
Permit No. 49085

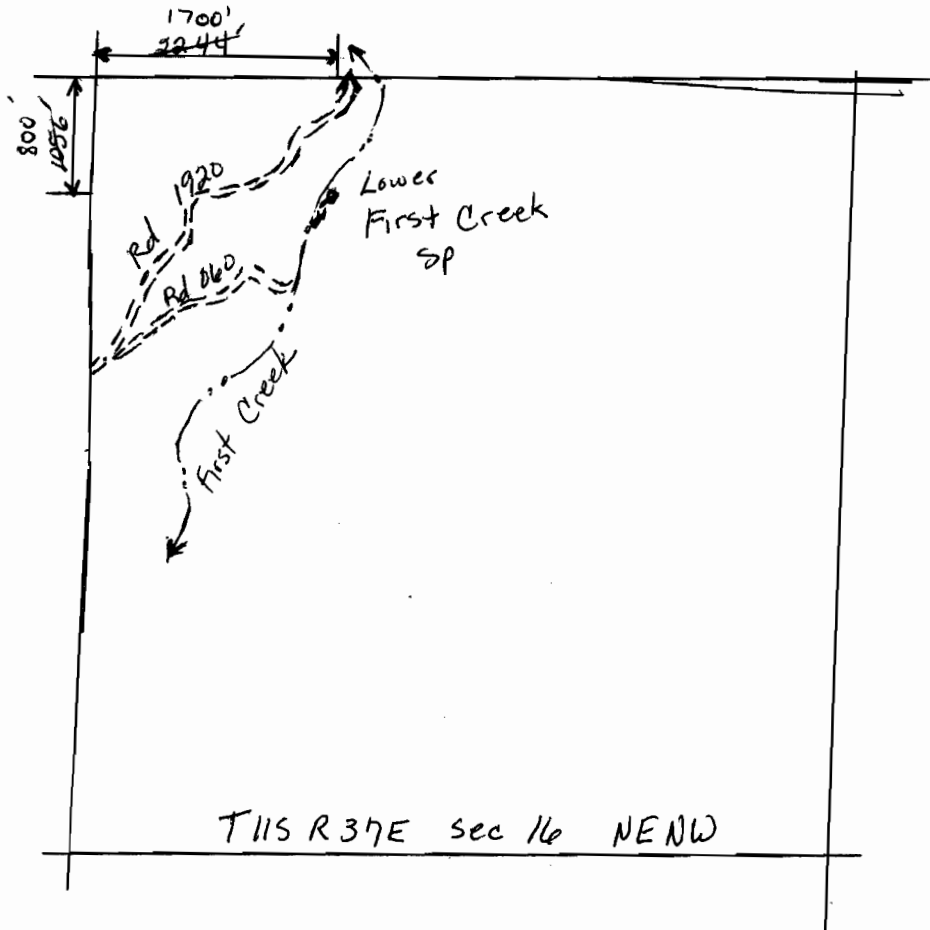

4" = 1 mile

N
↑
RECEIVED
JUN 24 1983
WATER RESOURCES DEPT.
SALEM, OREGON

RECEIVED
SEP 29 1982
WATER RESOURCES DEPT.
SALEM, OREGON