


Application No. 64243
Permit No. 49087

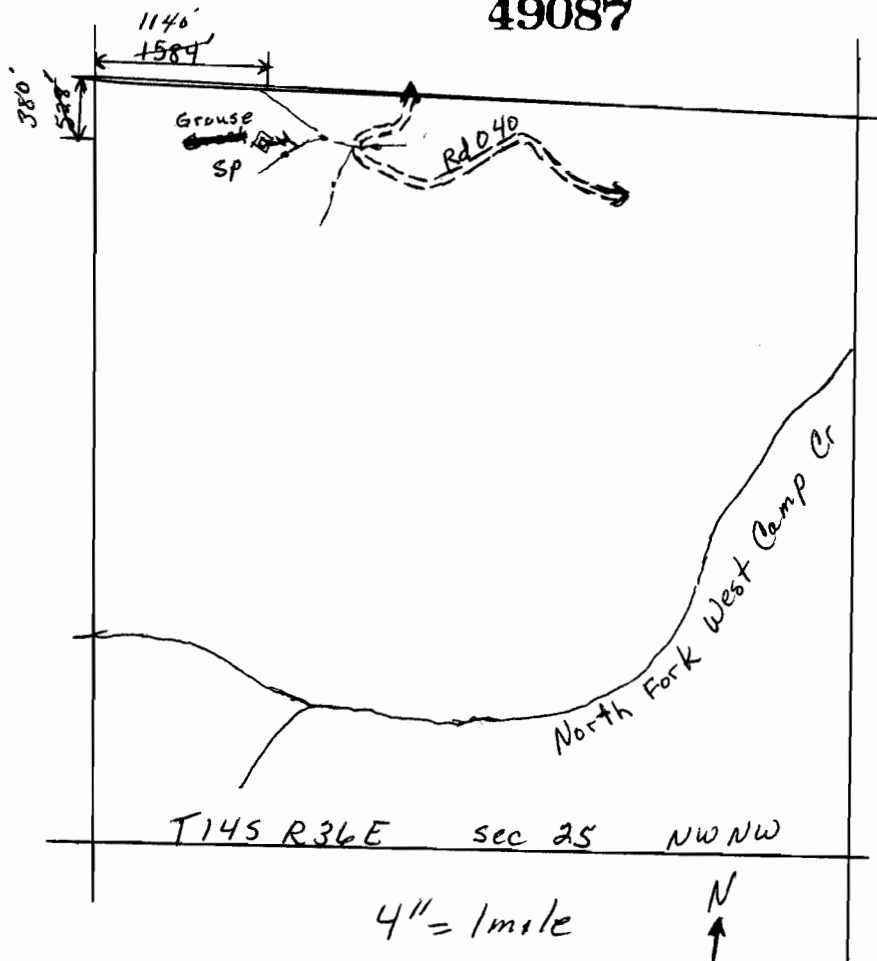

RECEIVED

SEP 29 1982

WATER RESOURCES DEPT.
SALEM, OREGON

RECEIVED

JUN 24 1993

WATER RESOURCES DEPT.
SALEM, OREGON