


Application No. 64244
Permit No. 49088

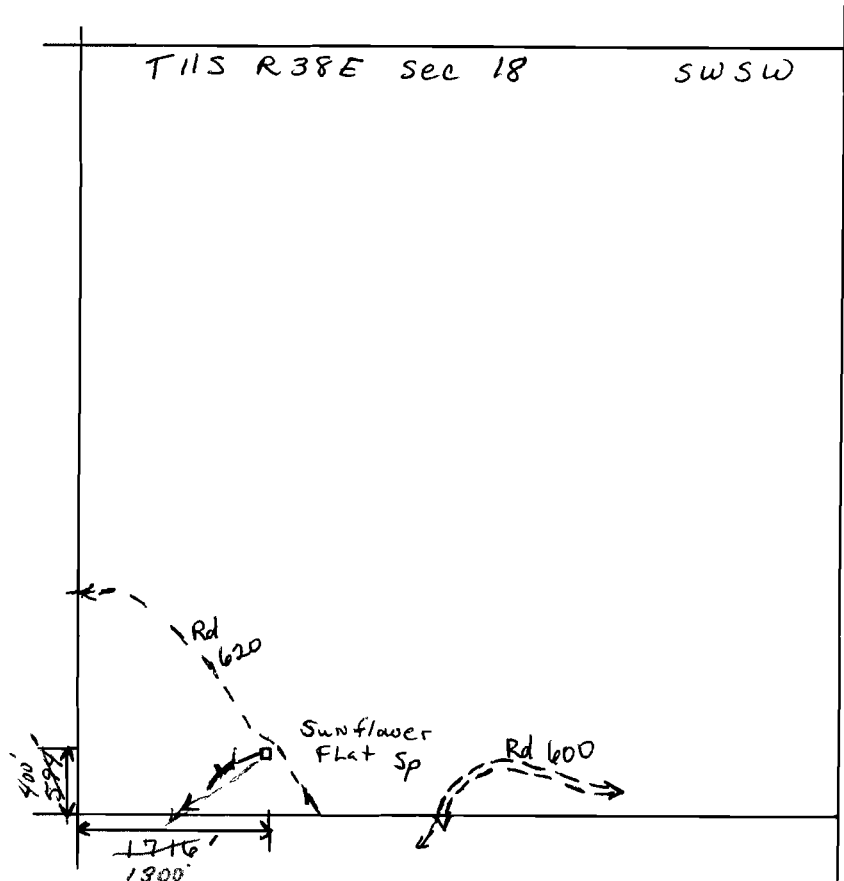

4" = 1 mile



RECEIVED

SEP 29 1982

WATER RESOURCES DEPT.
SALEM, OREGON

RECEIVED

JUN 24 1993

WATER RESOURCES DEPT.
SALEM, OREGON