


Application No. 64245
Permit No. 49089

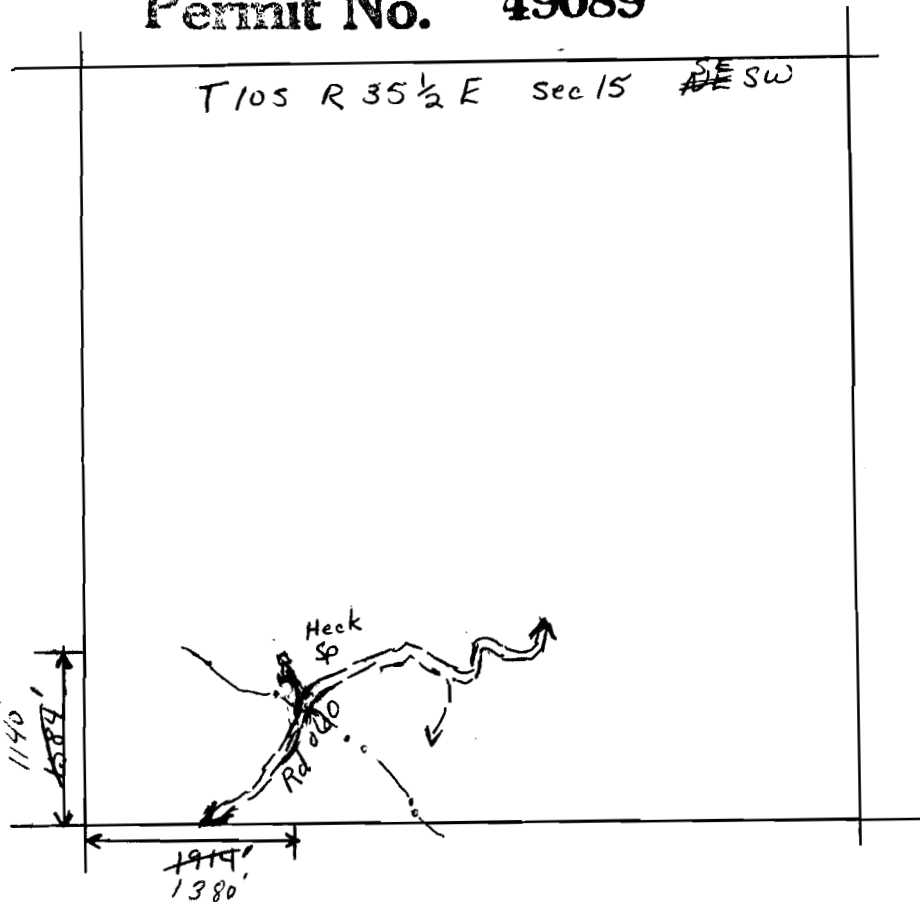

4" = 1 mile



RECEIVED
JUN 24 1983
WATER RESOURCES DEPT.
SALEM, OREGON

RECEIVED
SEP 29 1982
WATER RESOURCES DEPT.
SALEM, OREGON

RECEIVED
SEP 1 1983
WATER RESOURCES DEPT.
SALEM, OREGON