


Application No. 64246
Permit No. 49090

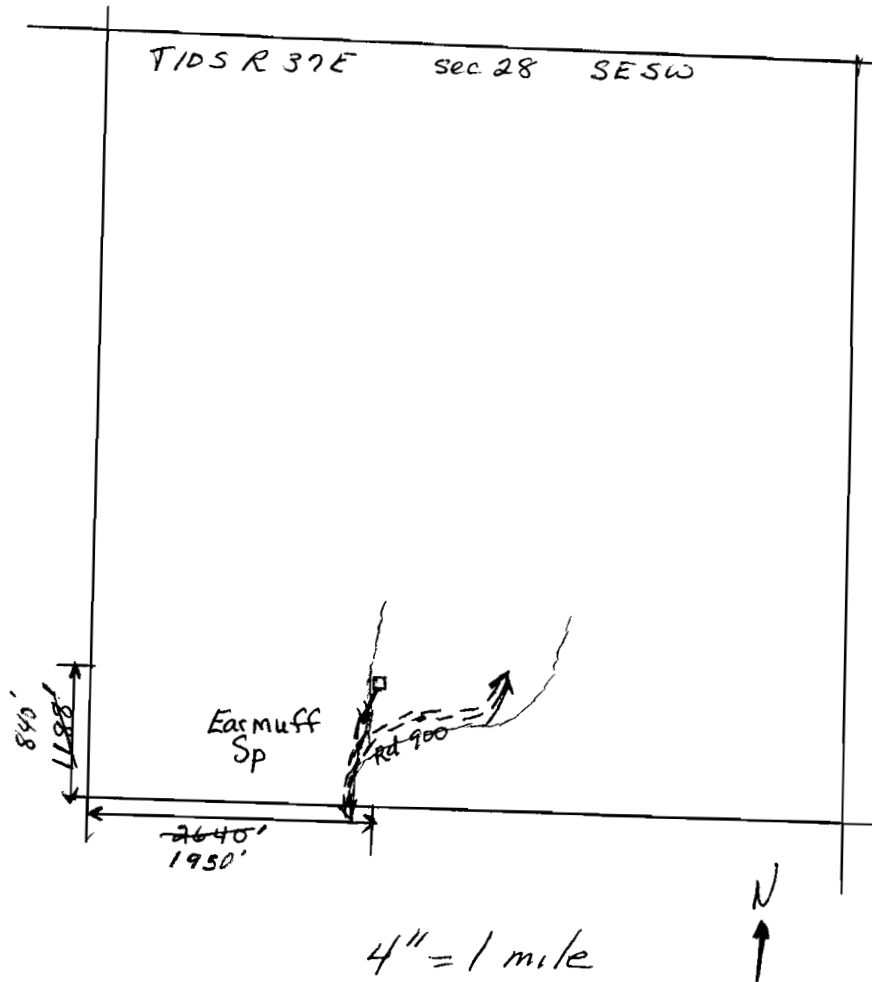

RECEIVED

JUN 24 1983

WATER RESOURCES DEPT. WATER RESOURCES DEPT.
SALEM, OREGON SALEM, OREGON

RECEIVED

SEP 29 1982