


Application No. 64248
Permit No. 49091

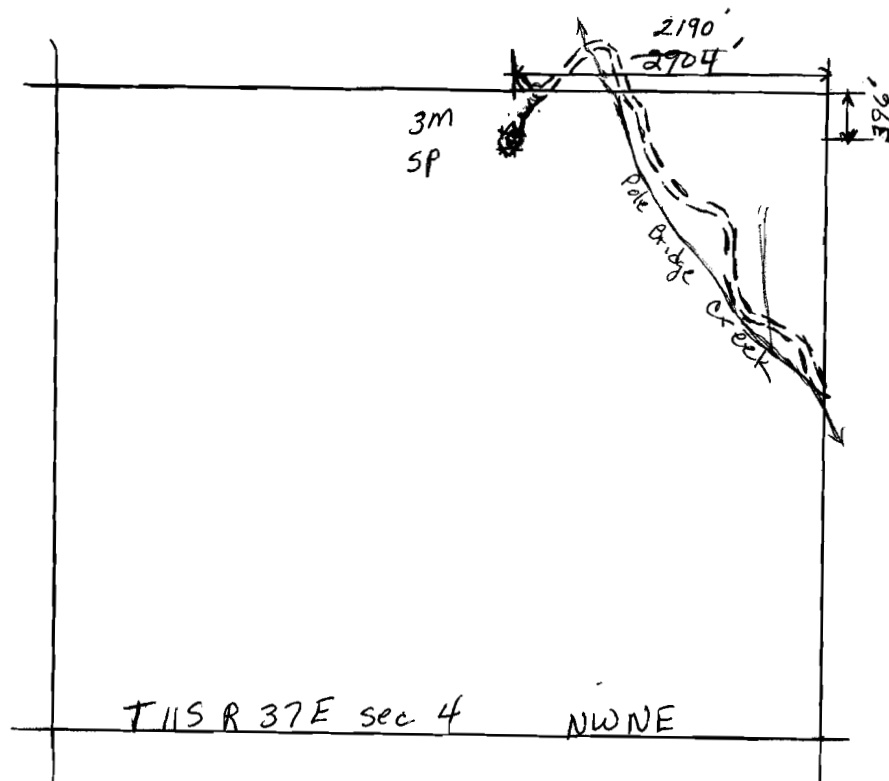

4" = 1 mile

RECEIVED

JUN 24 1983

↑ WATER RESOURCES DEPT.
SALEM, OREGON

RECEIVED

SEP 29 1982

WATER RESOURCES DEPT.
SALEM, OREGON