


Application No. 64249
Permit No. 49092

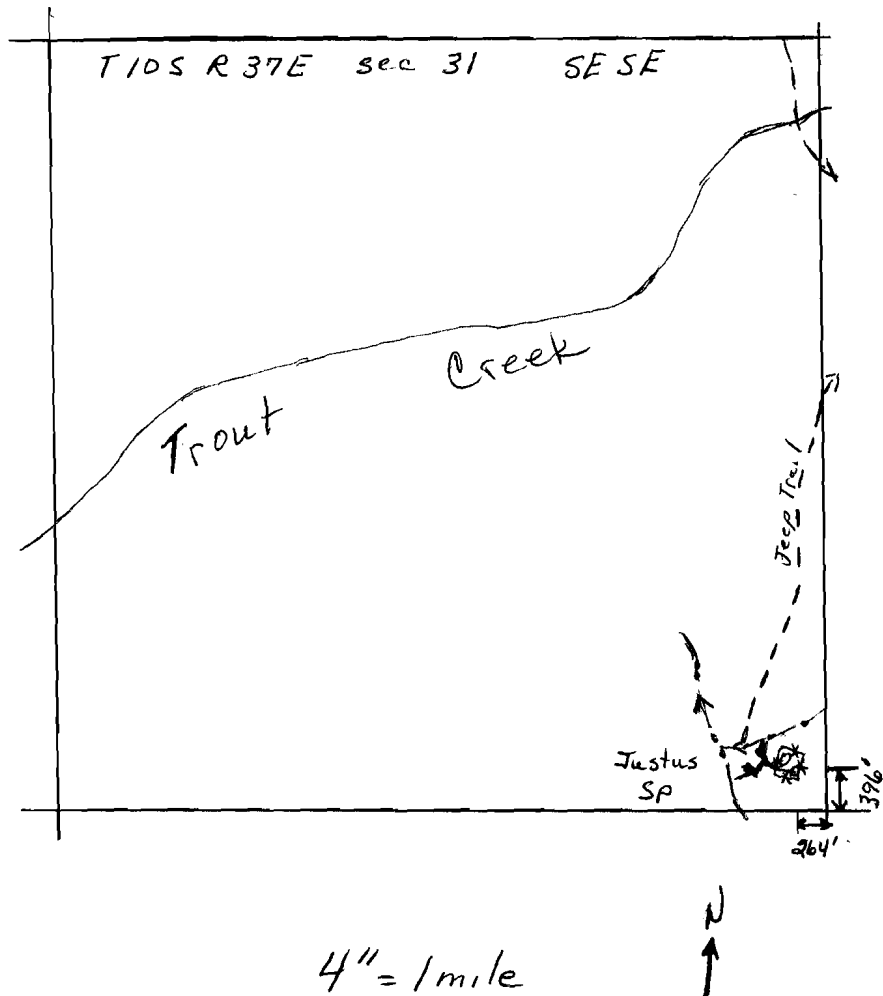

RECEIVED

SEP 29 1982

WATER RESOURCES DEPT.
SALEM, OREGON