


Application No. 64250
Permit No. 49093

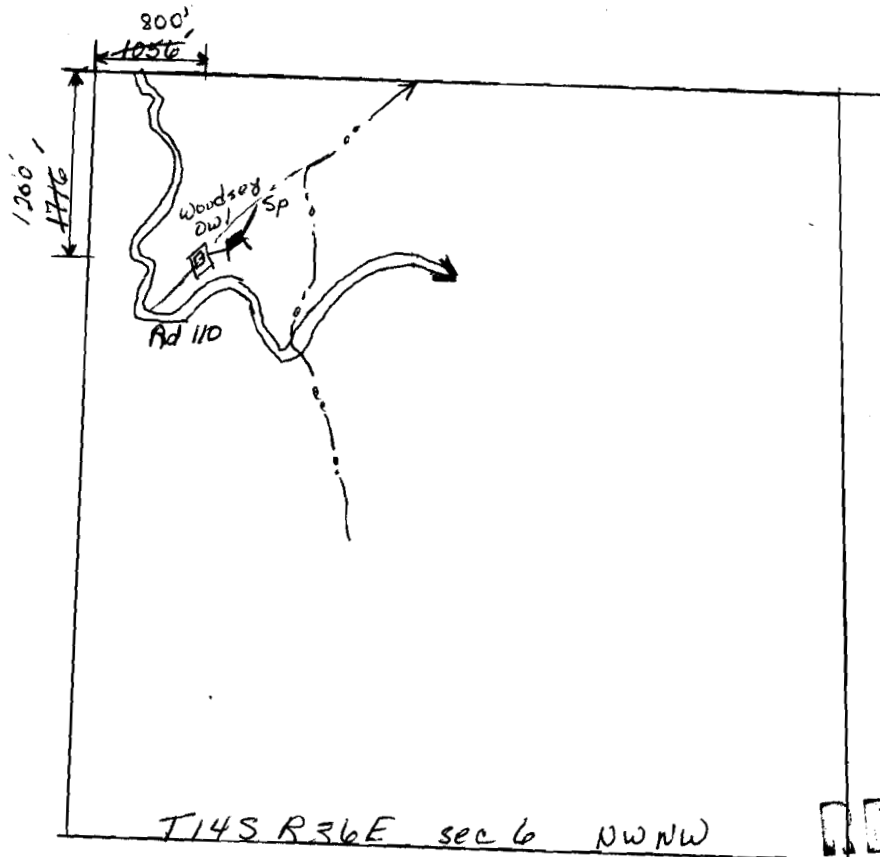

4" = 1 mile

RECEIVED

JUN 24 1993

WATER RESOURCES DEPT.
SALEM, OREGON

RECEIVED

SEP 29 1982

WATER RESOURCES DEPT.
SALEM, OREGON