


Application No. 64251  
Permit No. 49094

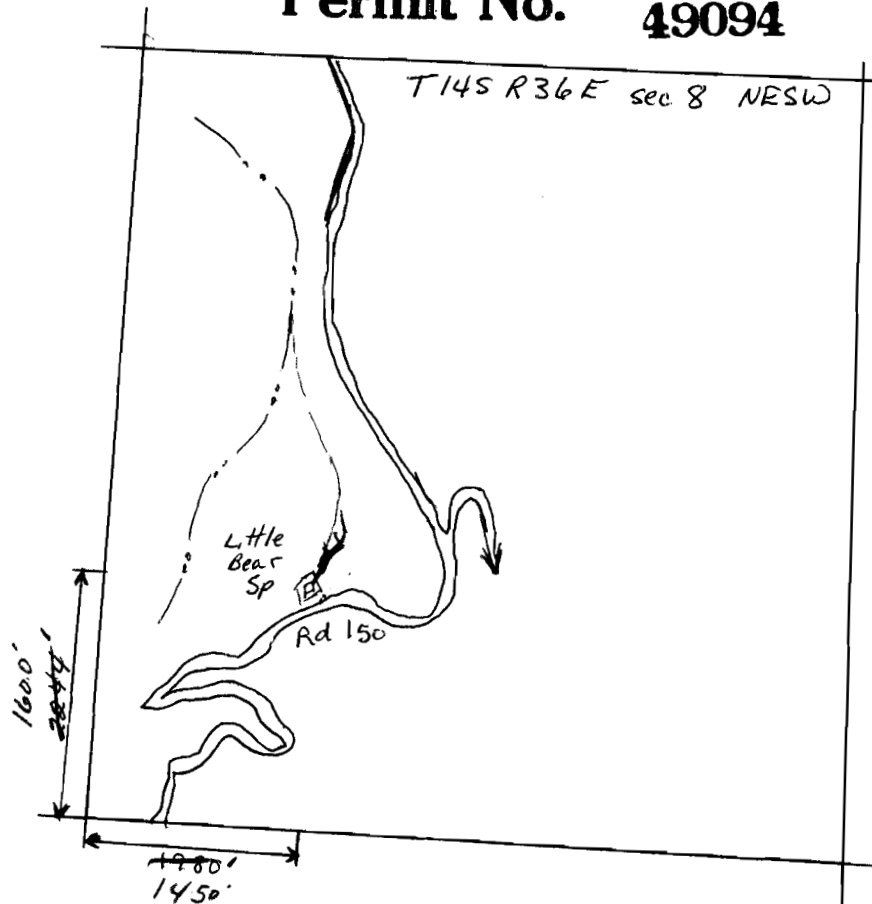

4" = 1 mile

RECEIVED

JUN 24 1983

WATER RESOURCES DEPT.  
SALEM, OREGON

RECEIVED

SEP 29 1982

WATER RESOURCES DEPT.  
SALEM, OREGON