

T11S R 38E Sec 10 SESE

RECEIVED


SEP 29 1982

WATER RESOURCES DEPT.
SALEM, OREGON

RECEIVED

JUN 24 1983

WATER RESOURCES DEPT.
SALEM, OREGON

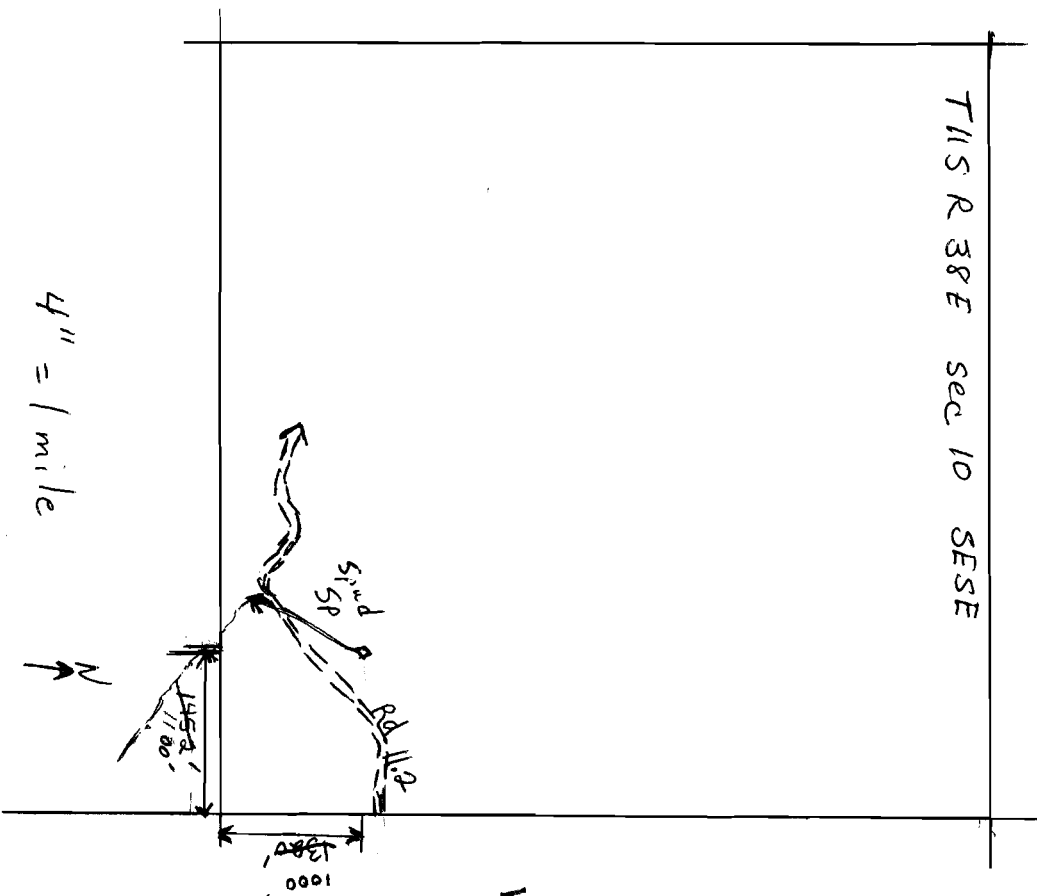

Application No. 64253
Permit No. 49096