


Application No. 64255
Permit No. 49098

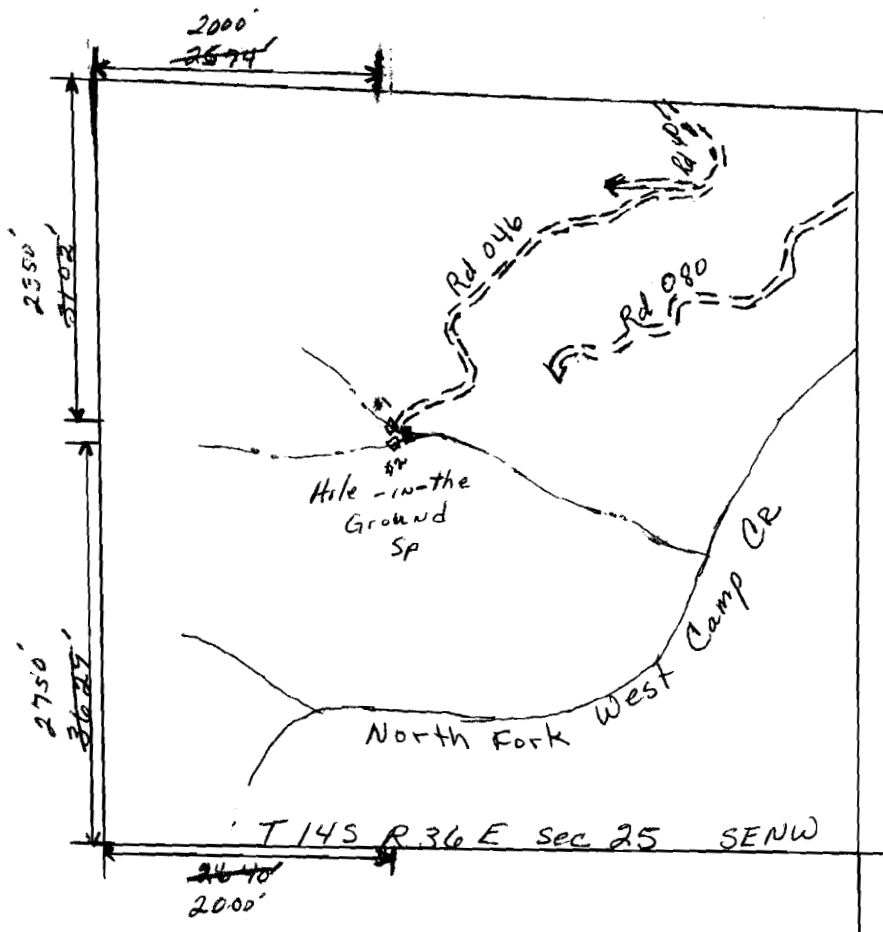

RECEIVED

SEP 29 1982
WATER RESOURCES DEPT.
SALEM, OREGON

RECEIVED

JUN 24 1983
WATER RESOURCES DEPT.
SALEM, OREGON