


Application No. 64252
Permit No. 49095

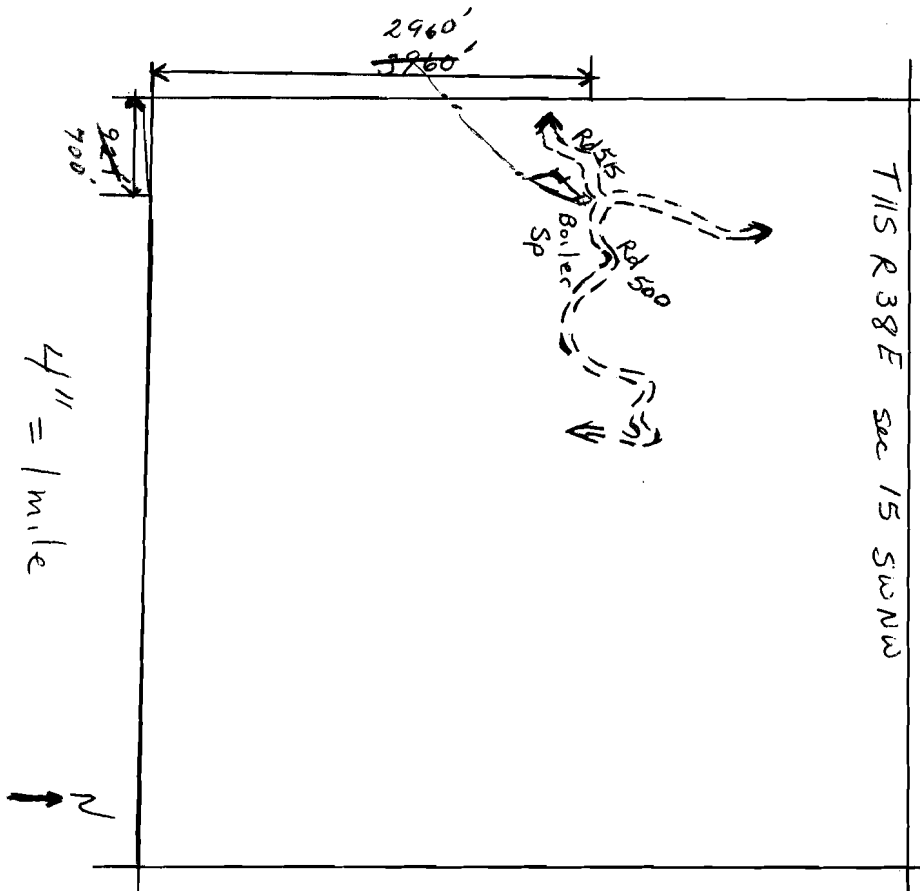

RECEIVED
JUN 24 1983
WATER RESOURCES DEPT.
SALEM, OREGON

RECEIVED
SEP 29 1982
WATER RESOURCES DEPT.
SALEM, OREGON