


REVISED

007181983

WATER RESOURCES DEPT.
SALEM, OREGON

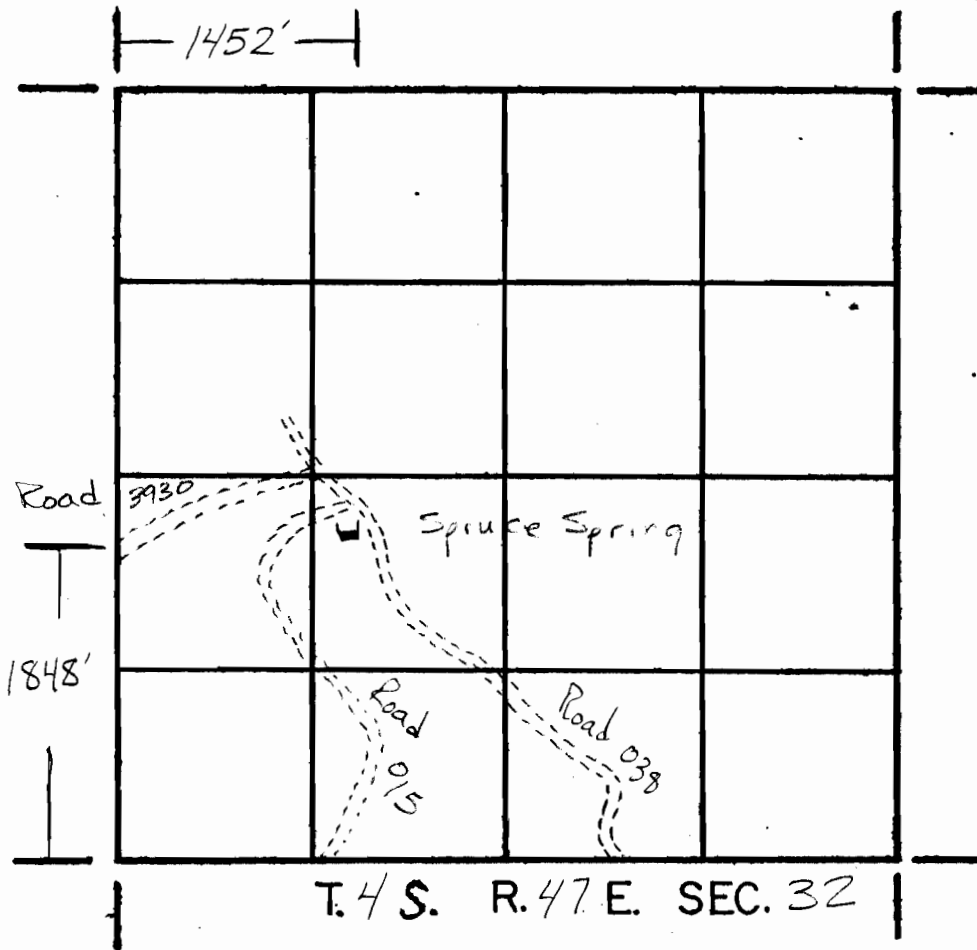

4 Inches = 1 Mile

Application No. 67573
Permit No. 49103

Prepared By _____