


RECEIVED

OCT 13 1983

**WATER RESOURCES DEPT.
SALEM, OREGON**

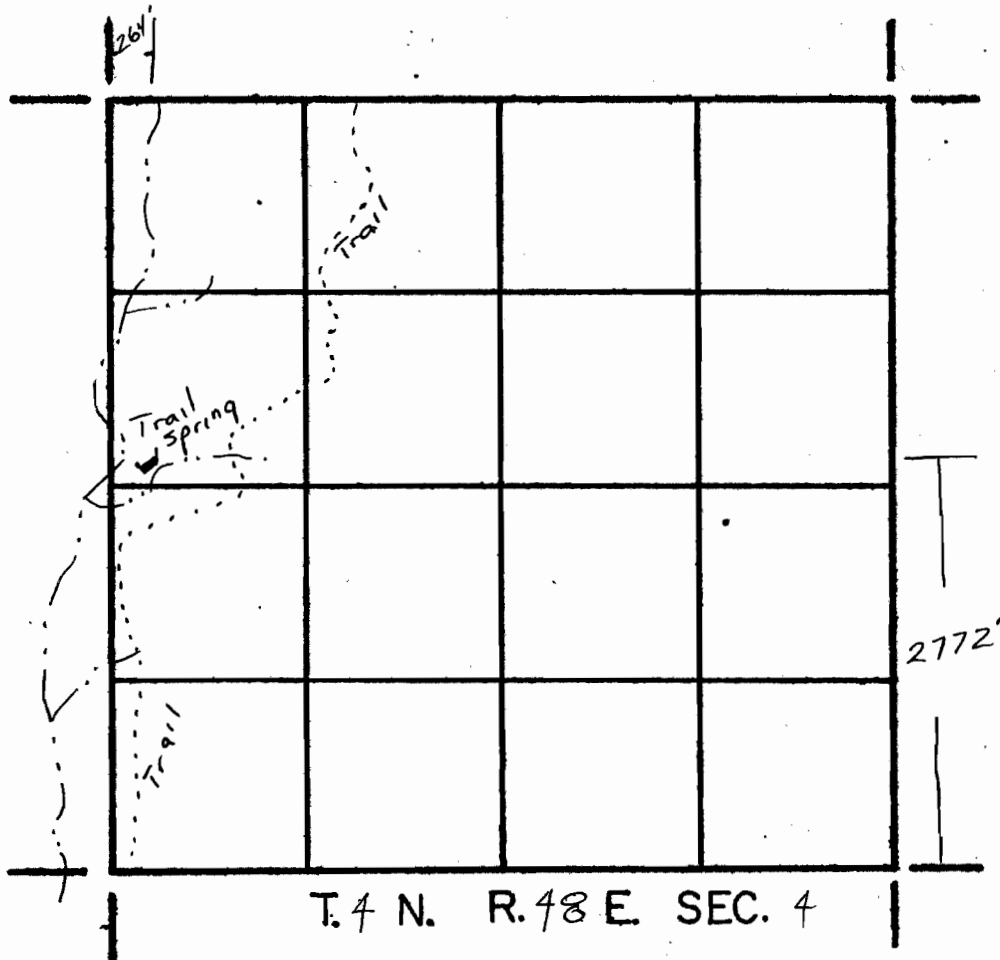

↑
N
↓

4 Inches = 1 Mile

Application No. 67583
Permit No. 49113

Prepared By Robert J. Baney