N

Application No. 64260
Permit No. **49129**

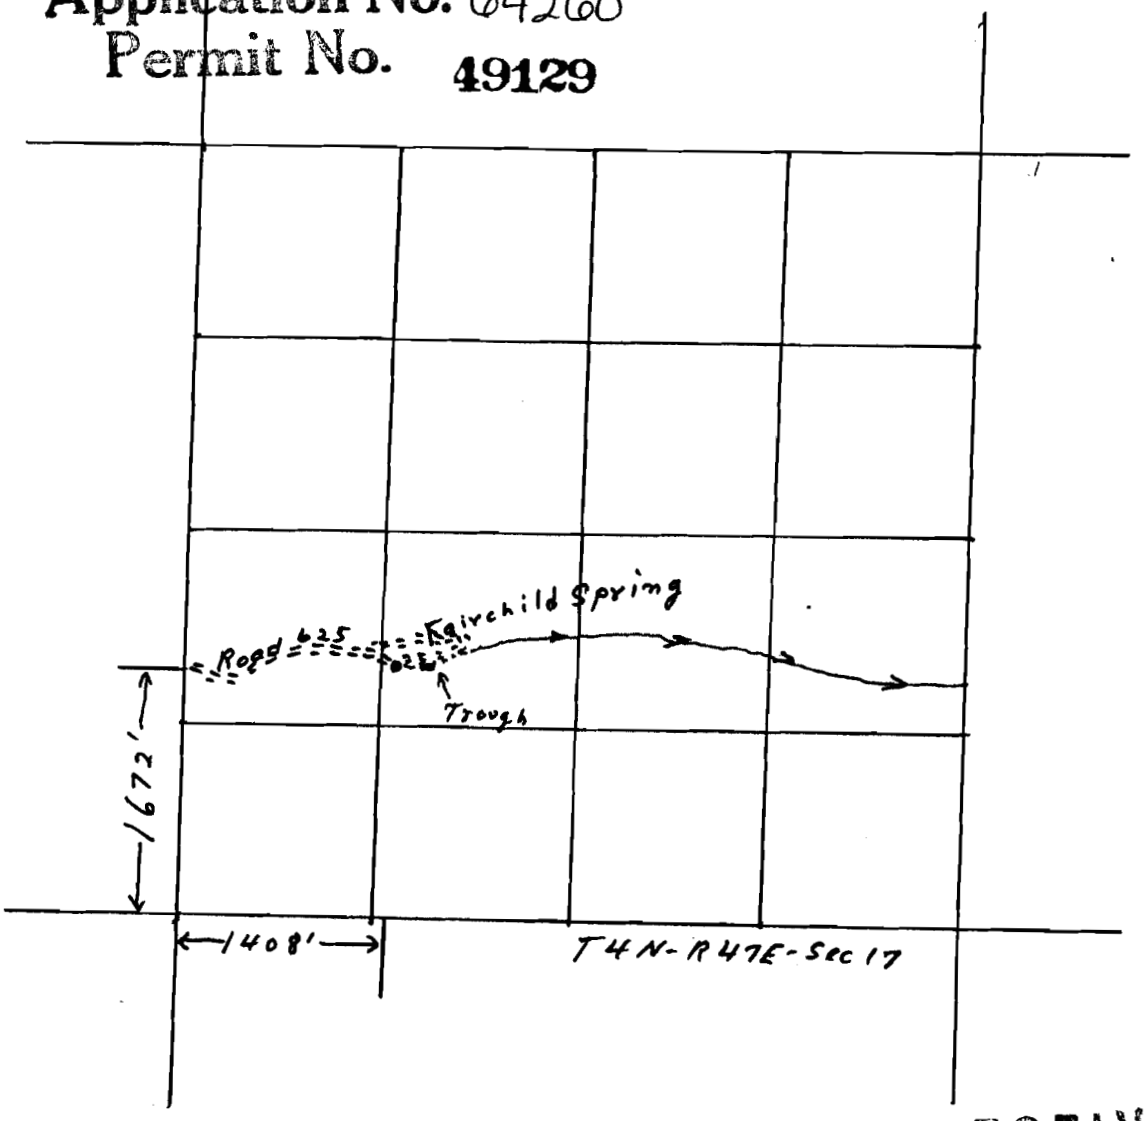

RECEIVED
SEP 30 1982
WATER RESOURCES DEPT.
SALEM, OREGON

4 inches = 1 mile