


11 4

Application No. 64261
Permit No. 49130

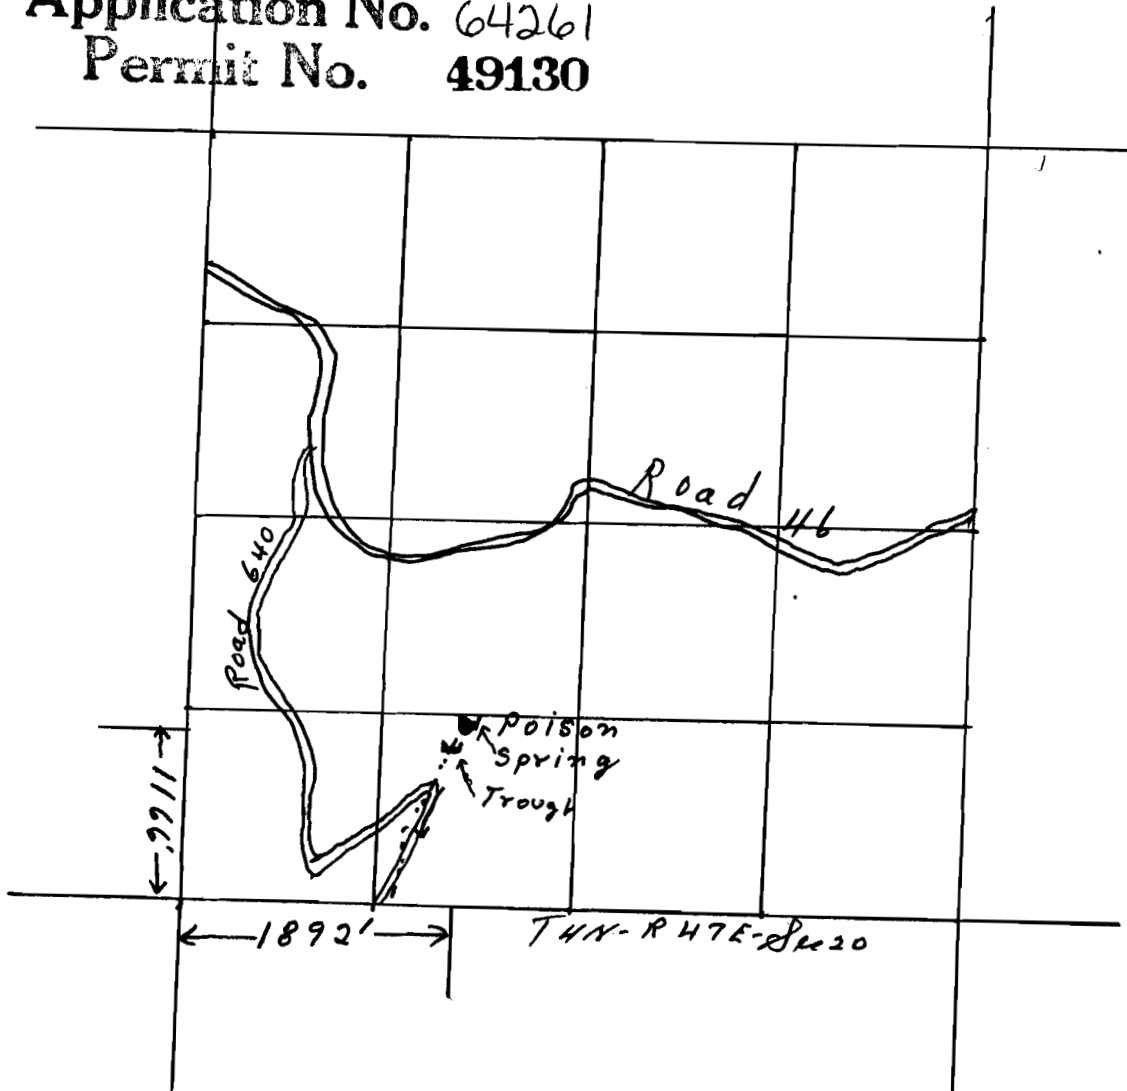

RECEIVED

SEP 30 1982

WATER RESOURCES DEPT.
SALEM, OREGON

4 inches = 1 mile