


4  
N

Application No. 64263  
Permit No. 49132

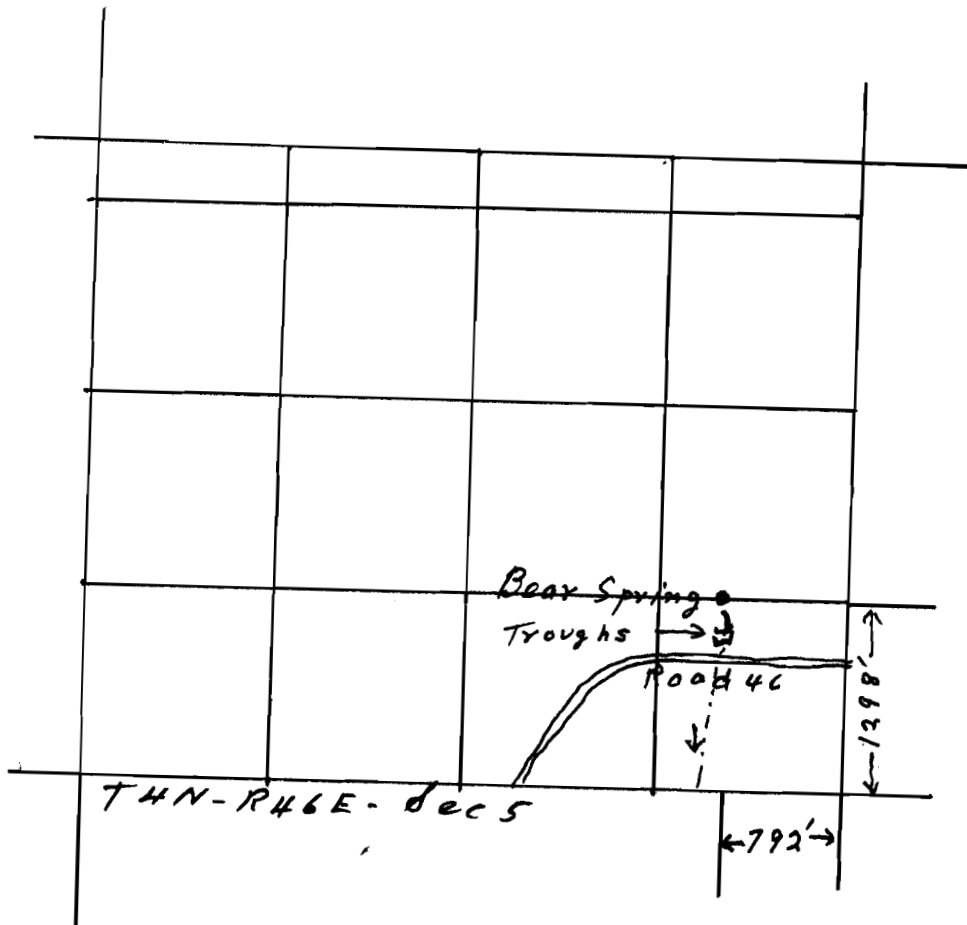

RECEIVED

SEP 30 1982

WATER RESOURCES DEPT.  
SALEM, OREGON

4 inches = 1 mile