


N ↑

Application No. 64264
Permit No. 49133

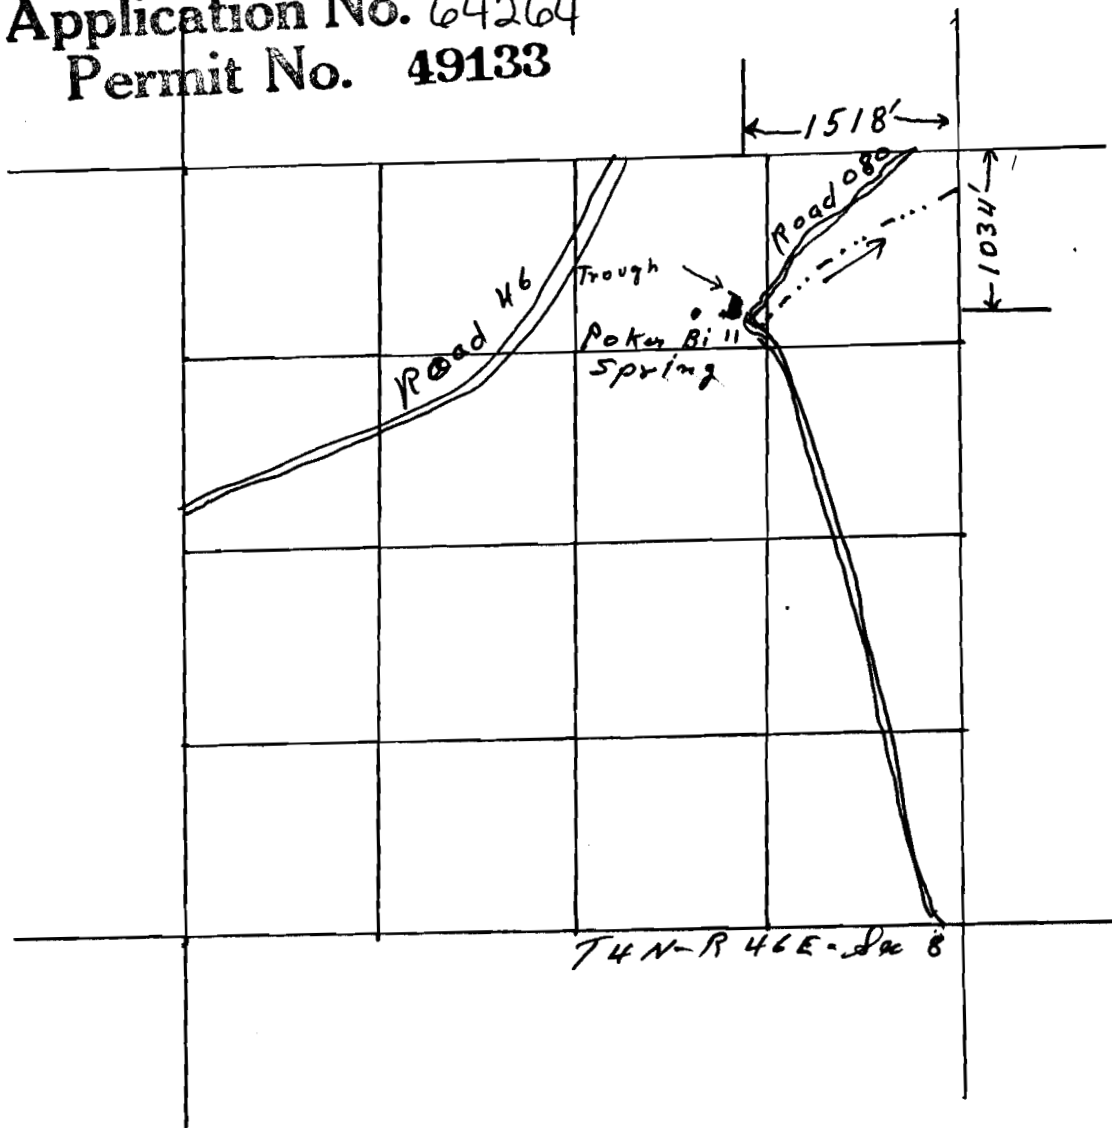

RECEIVED

SEP 30 1982

WATER RESOURCES DIV.
SALEM, OREGON

4 inches = 1 mile