


N

Application No. 64266
Permit No. 49135

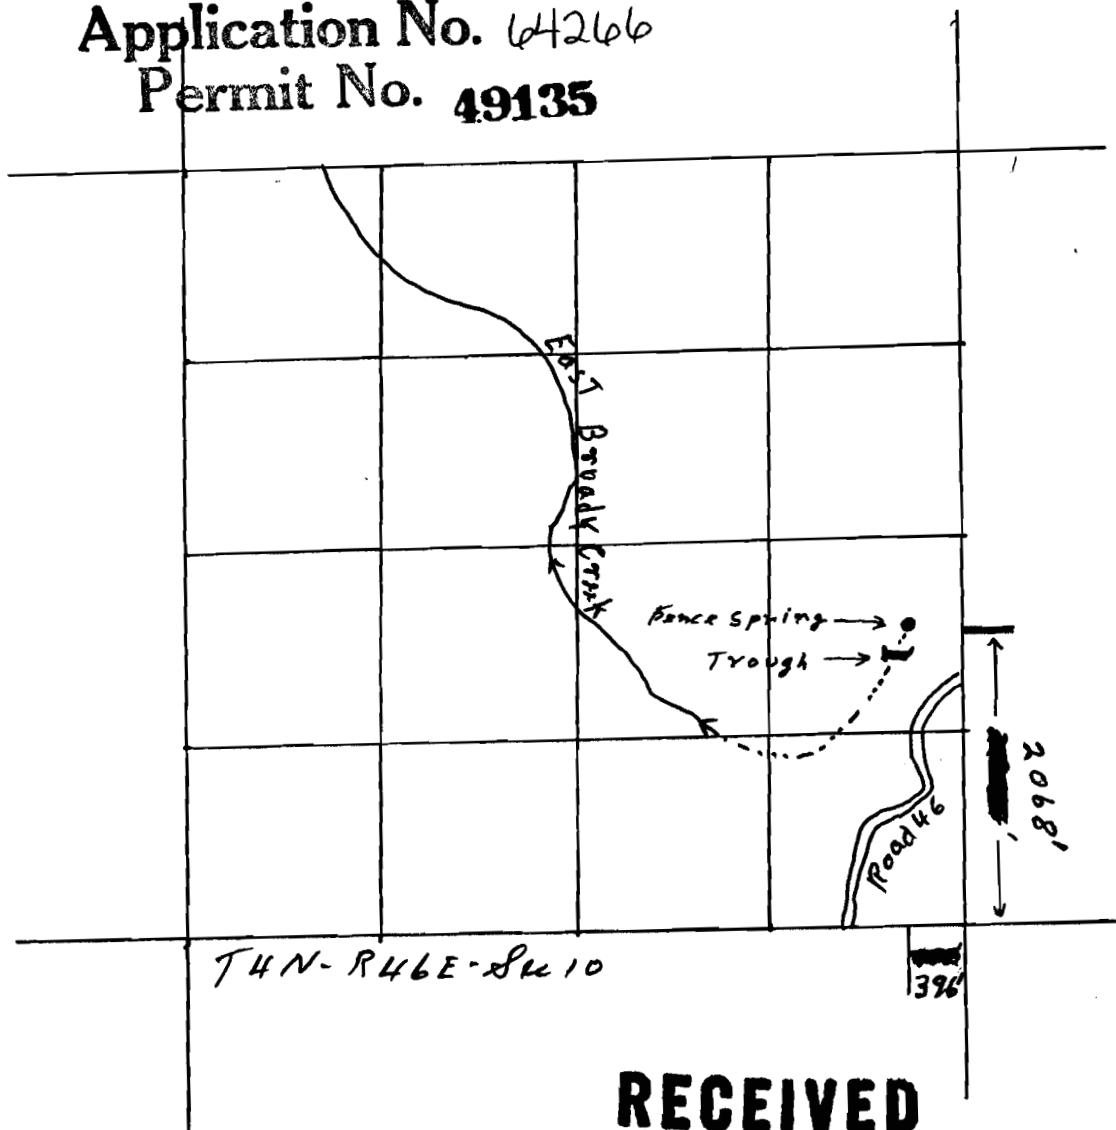

RECEIVED

JUL 18 1983

WATER RESOURCES DEPT.
SALEM, OREGON

RECEIVED

SEP 30 1982

WATER RESOURCES DEPT.
SALEM, OREGON

4 inches = 1 mile