


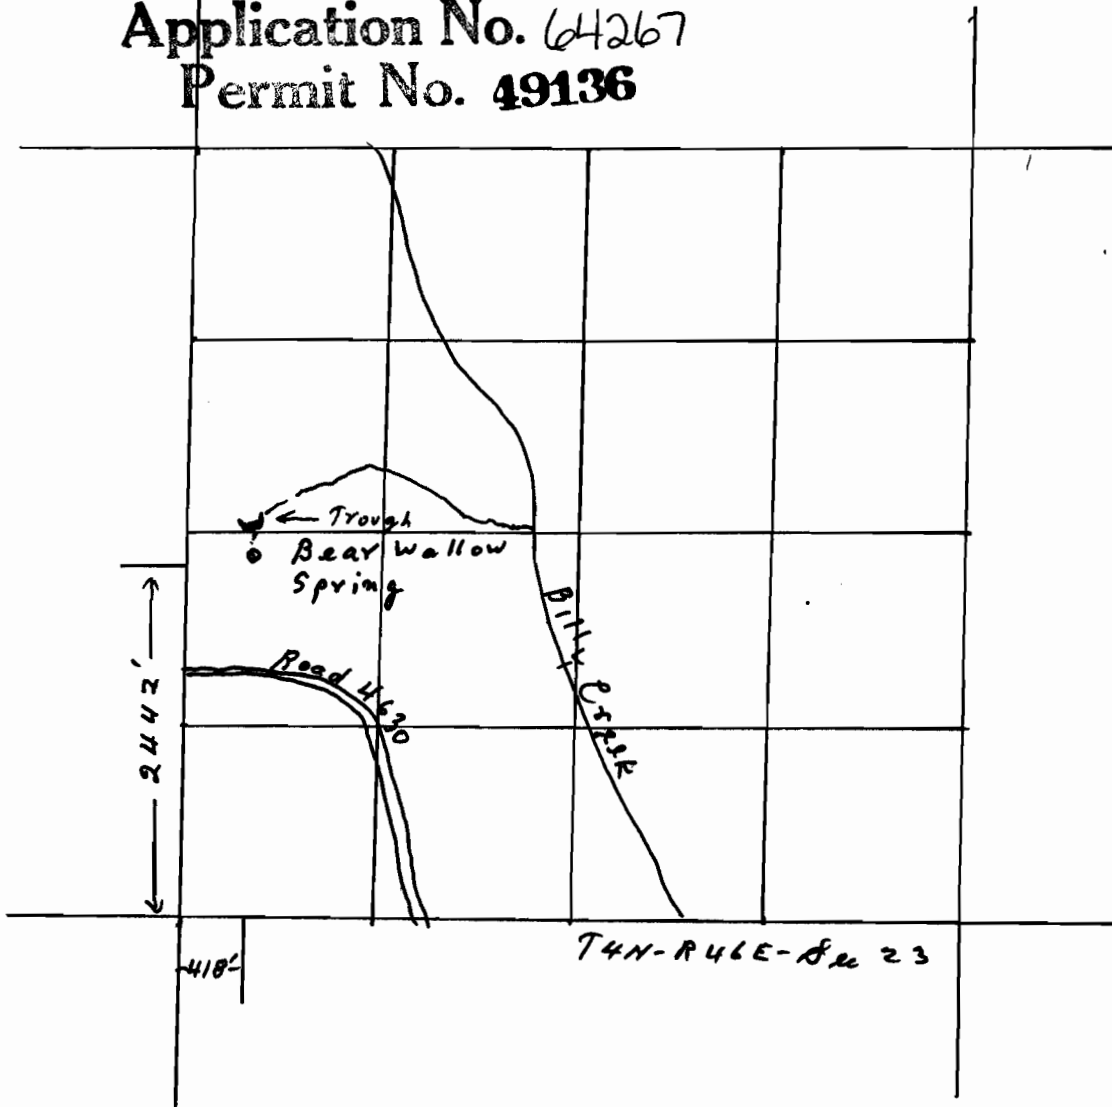

Application No. 64267
Permit No. 49136



RECEIVED

JUL 18 1983

WATER RESOURCES DEPT.
SALEM, OREGON

4 inches = 1 mile

RECEIVED

SEP 30 1982

WATER RESOURCES DEPT.
SALEM, OREGON