


Application No. 64268
Permit No. 49137

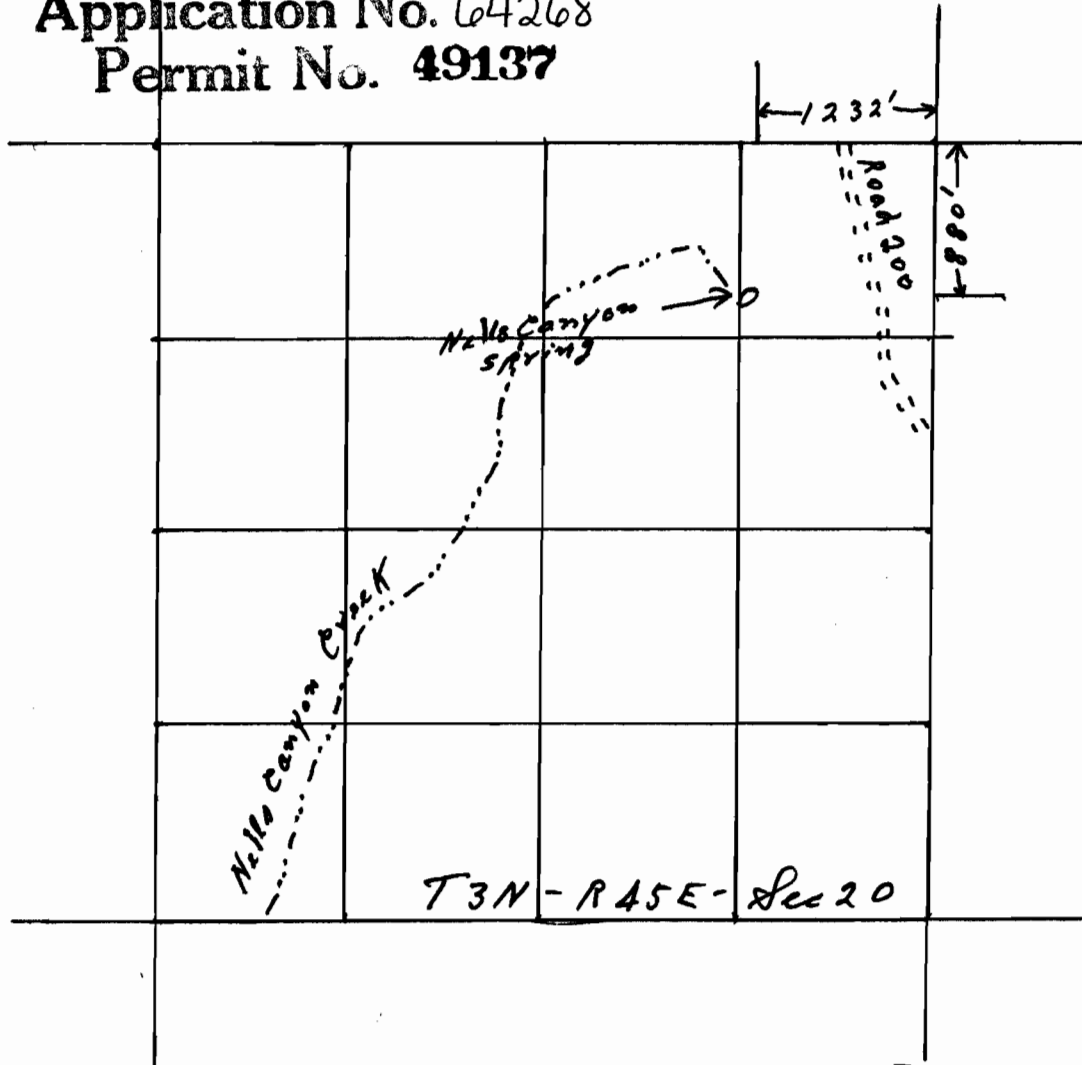

RECEIVED

SEP 30 1982

WATER RESOURCES DEPT.
SALEM, OREGON

4 inches = 1 mile