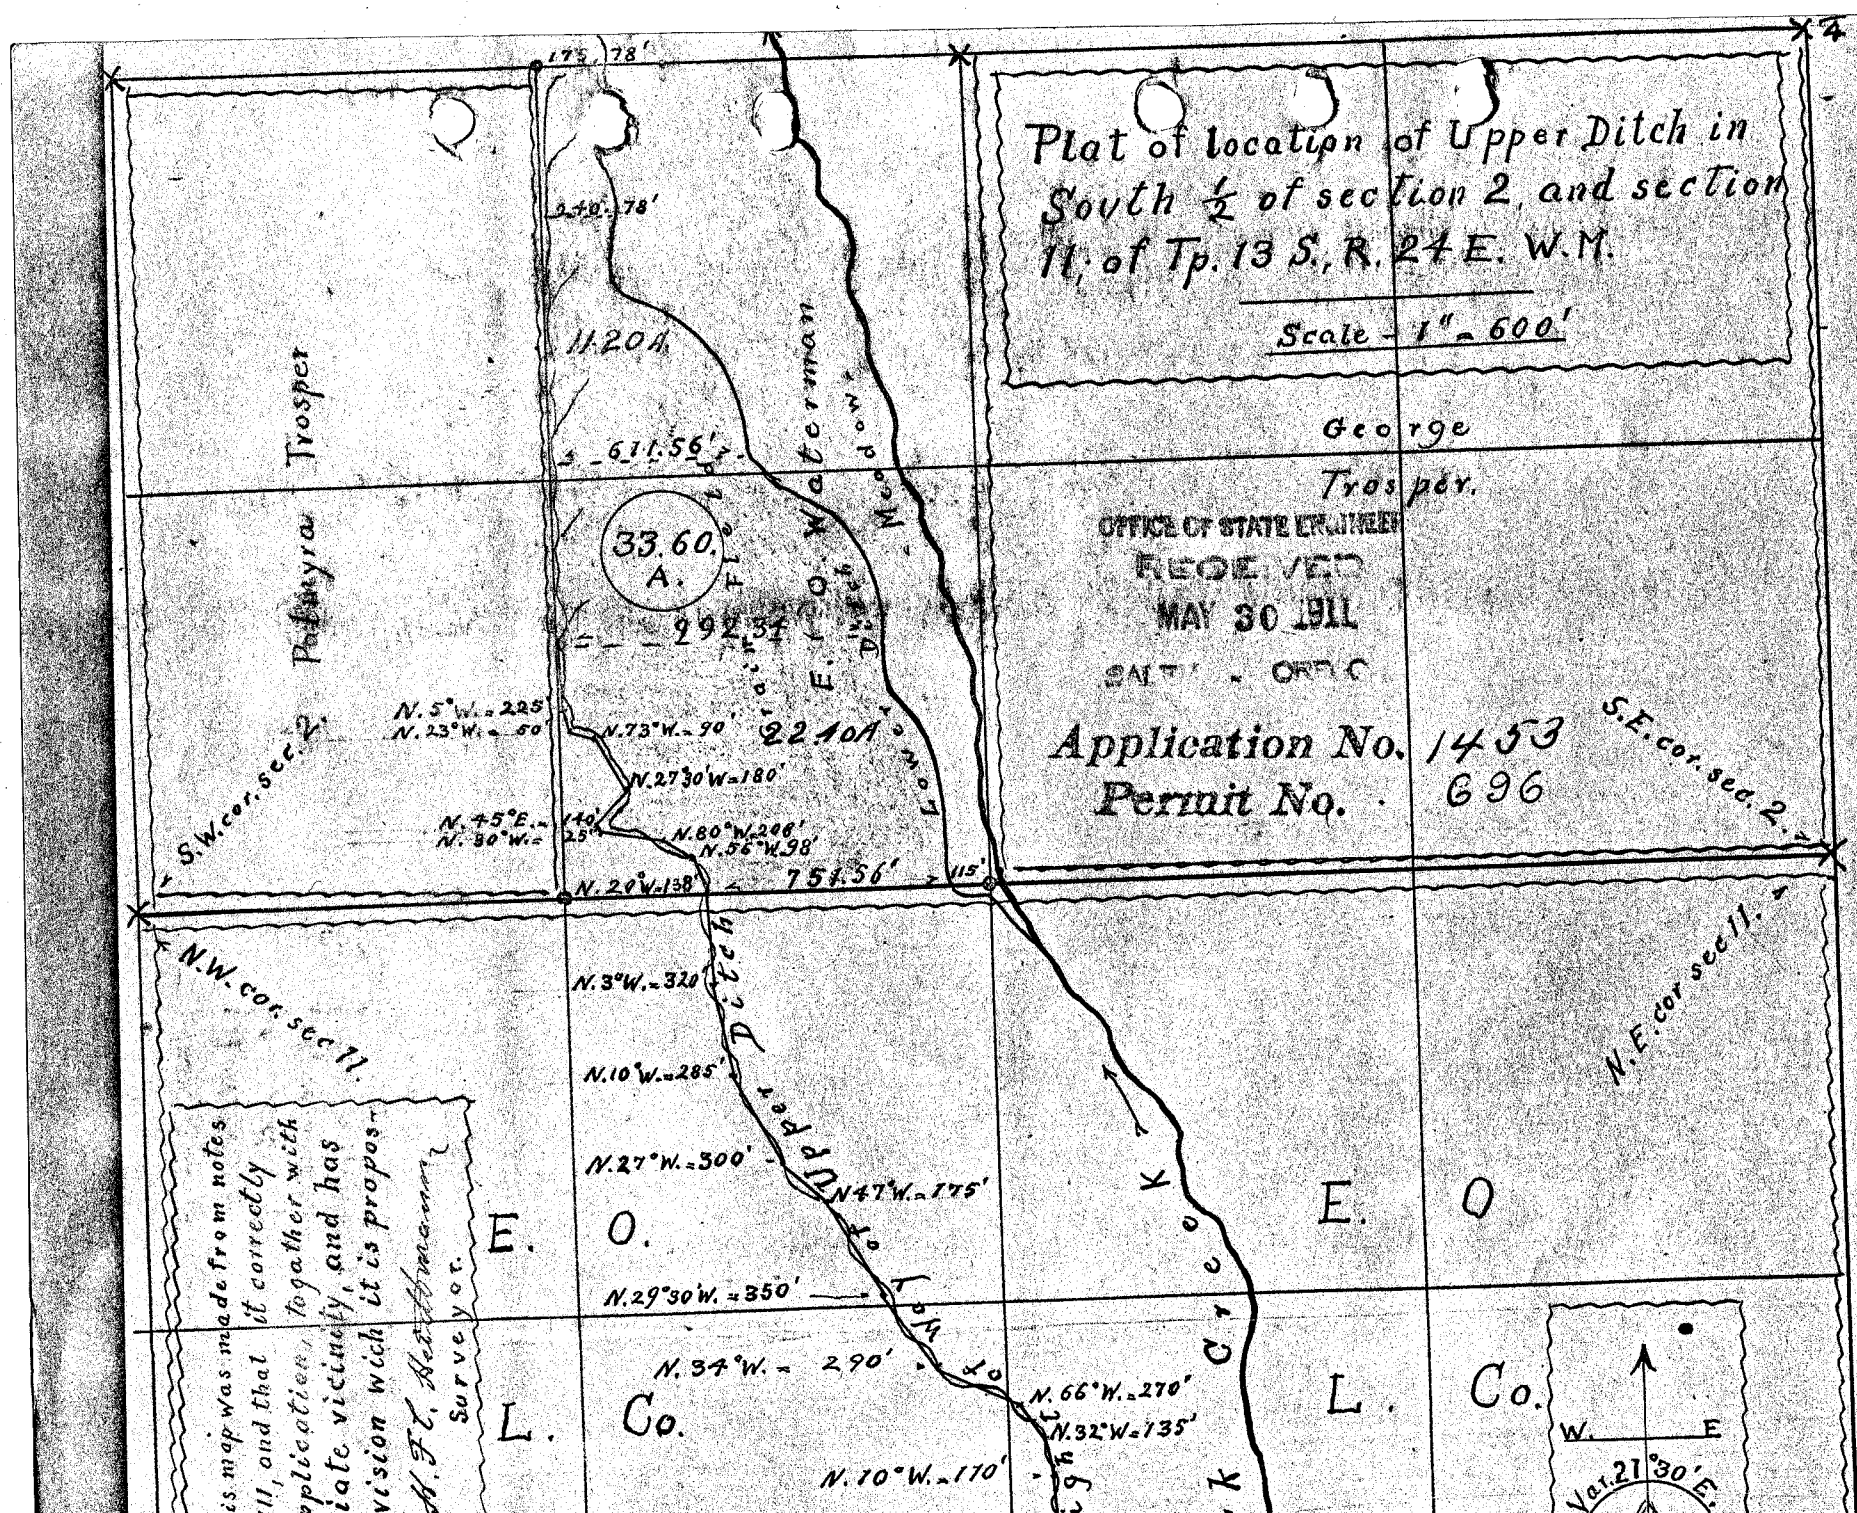
Plat of location of Upper Ditch in South ½ of section 2, and section 11, of Tp. 13 S., R. 24 E. W.M.
Scale - 1" = 600'
George Trosper.
OFFICE OF STATE ENGINEER
RECEIVED
MAY 30 1911
SALEM, OREGON
Application No. 1453
Permit No. 696
Trosper
Palmyra
S.W. cor. sec. 2
S.E. cor. sec. 2
N.W. cor. sec. 11
N.E. cor. sec. 11
33.60 A.
22.10 A.
11.20 A.
Meadow
Upper Ditch
Wateman Creek
N. 5° W. = 225'
N. 23° W. = 50'
N. 73° W. = 90'
N. 27° 30' W. = 180'
N. 45° E. = 140'
N. 30° W. = 25'
N. 80° W. = 206'
N. 56° W. 98'
N. 29° W. 138'
751.56'
N. 3° W. = 320'
N. 10° W. = 285'
N. 27° W. = 300'
N. 47° W. = 175'
N. 29° 30' W. = 350'
N. 34° W. = 290'
N. 66° W. = 270'
N. 32° W. = 135'
N. 10° W. = 170'
E. O. L. Co.
W. E
Var. 21° 30' E.
This map was made from notes it correctly to gather with applications and has vicinity, and has it is proposed
H. F. Hartmann
Surveyor.

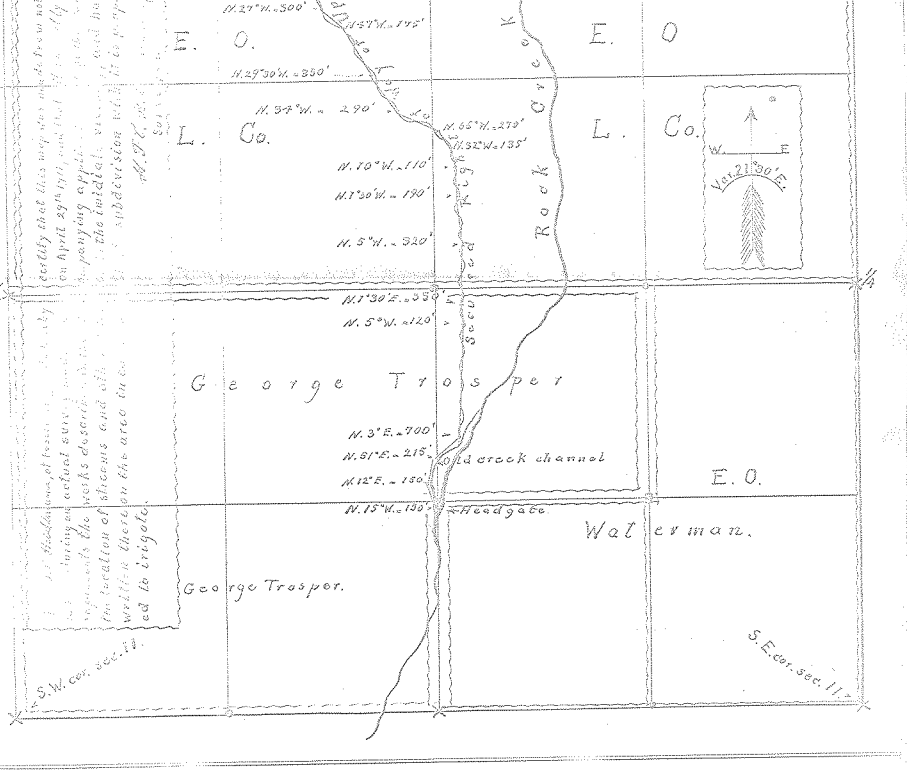
E. O.
E. O
L. Co.
L. Co.
N. 27° W. = 500'
N. 29° 30' W. = 850'
N. 37° W. = 290'
N. 65° W. = 270'
N. 32° W. = 135'
N. 10° W. = 110'
N. 1° 30' W. = 190'
N. 5° W. = 320'
N. 1° 30' E. = 350'
N. 5° W. = 120'
N. 3° E. = 700'
N. 61° E. = 215'
N. 12° E. = 150'
N. 15° W. = 195'
Headgate
Old creek channel
Second Rock Creek
George Trosper
Waterman.
E. O.
George Trosper.
S.W. cor. sec. 11.
S.E. cor. sec. 11
W.
E.
Var. 21° 30' E.