




RECEIVED

SEP 30 1982

WATER RESOURCES DEPT.
SALEM, OREGON

Application No. 64269
Permit No. 49138

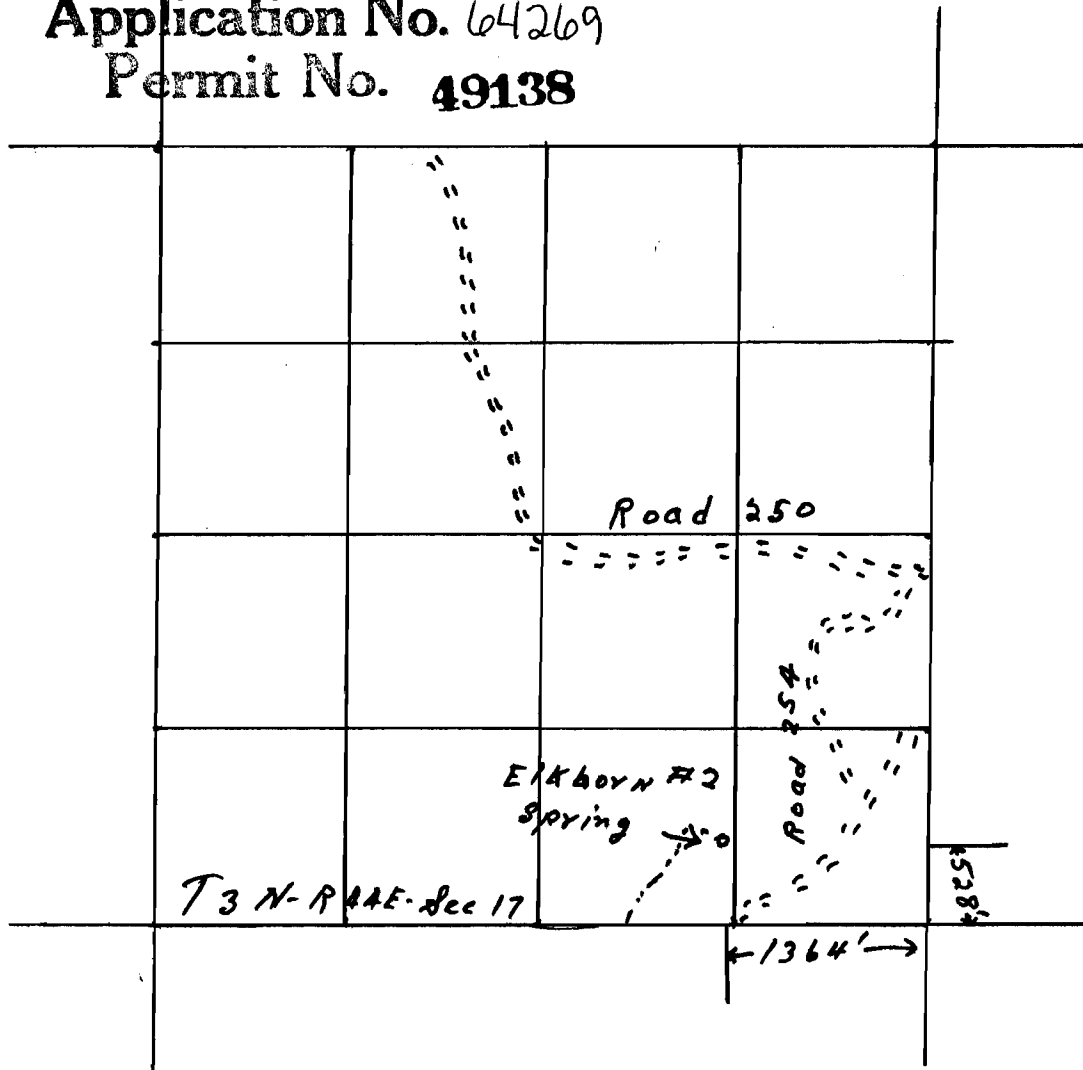

4 inches = 1 mile