


N ↑

Application No. 64270  
Permit No. 49139

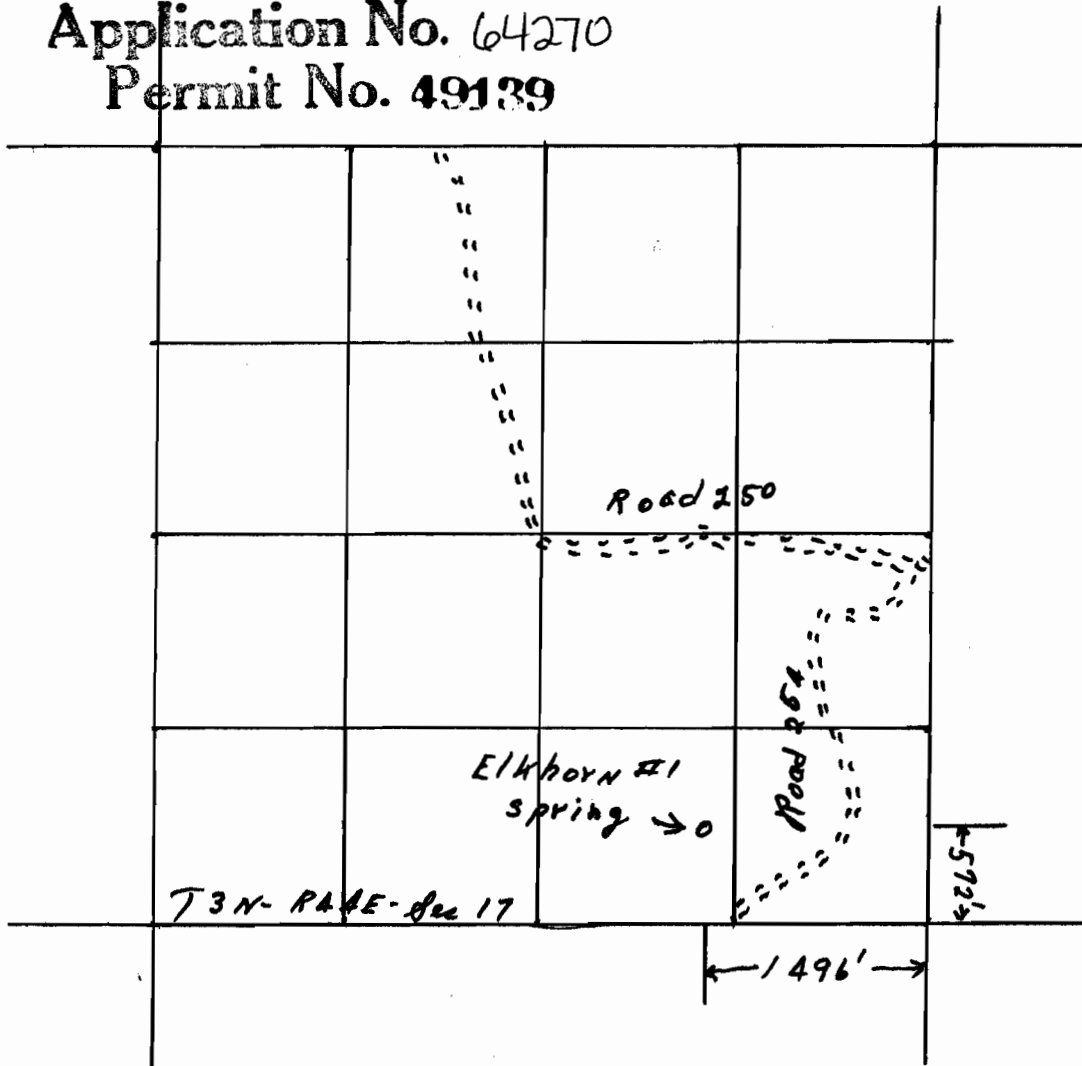

RECEIVED

SEP 30 1982

WATER RESOURCES DEPT.  
SALEM, OREGON

4 inches = 1 mile