


Application No. 64271
Permit No. 19140

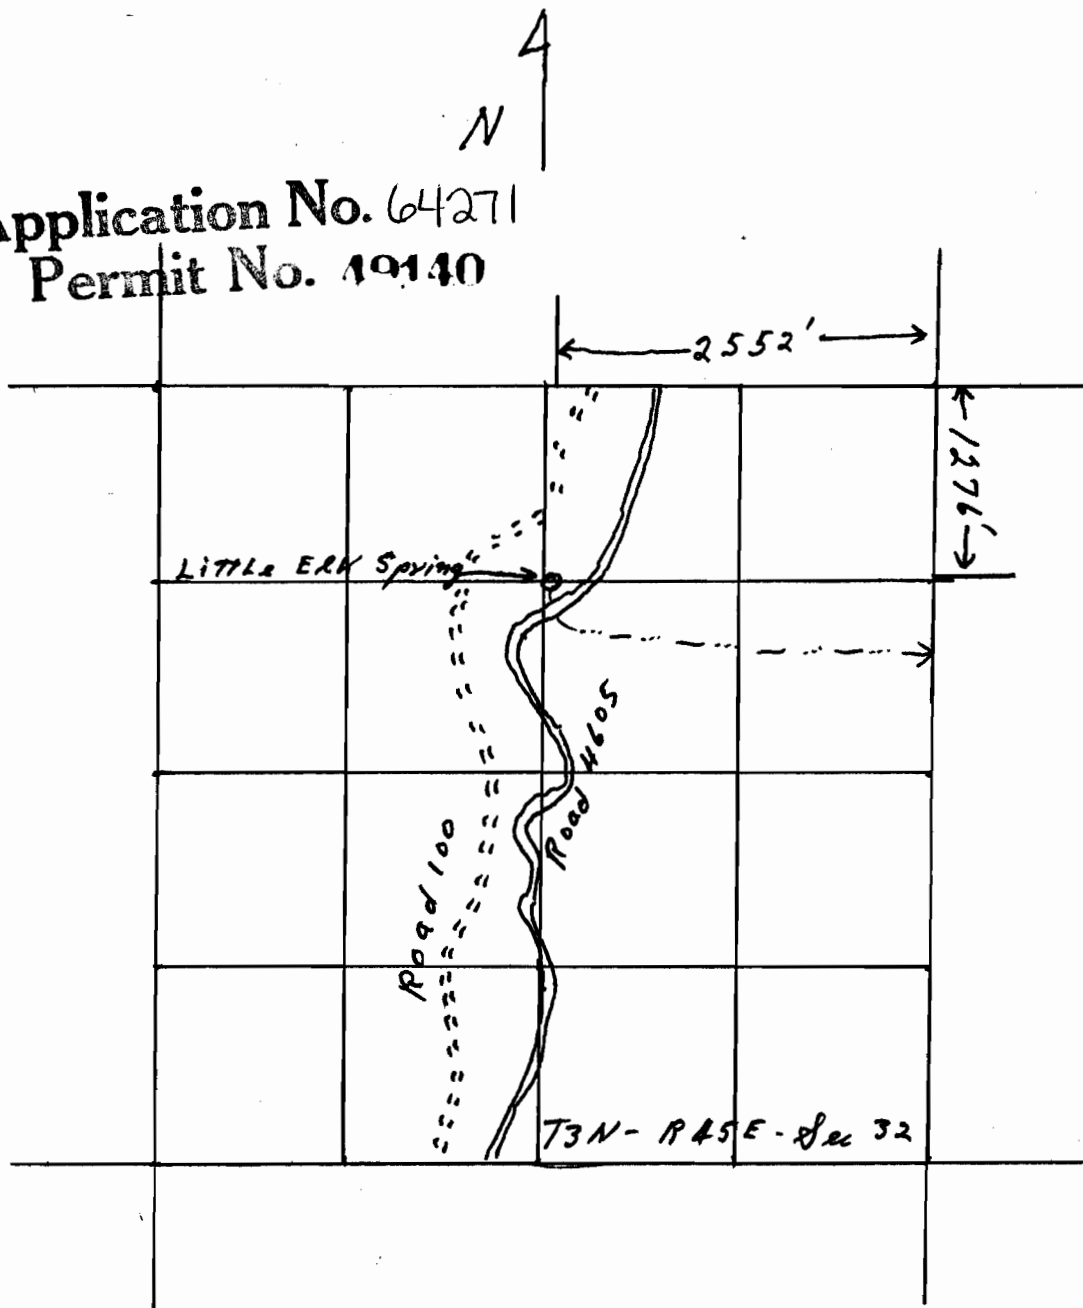

RECEIVED

SEP 30 1982

WATER RESOURCES DEPT.
SALEM, OREGON

4 inches = 1 mile