


N ↑

Application No. 64272
Permit No. 49141

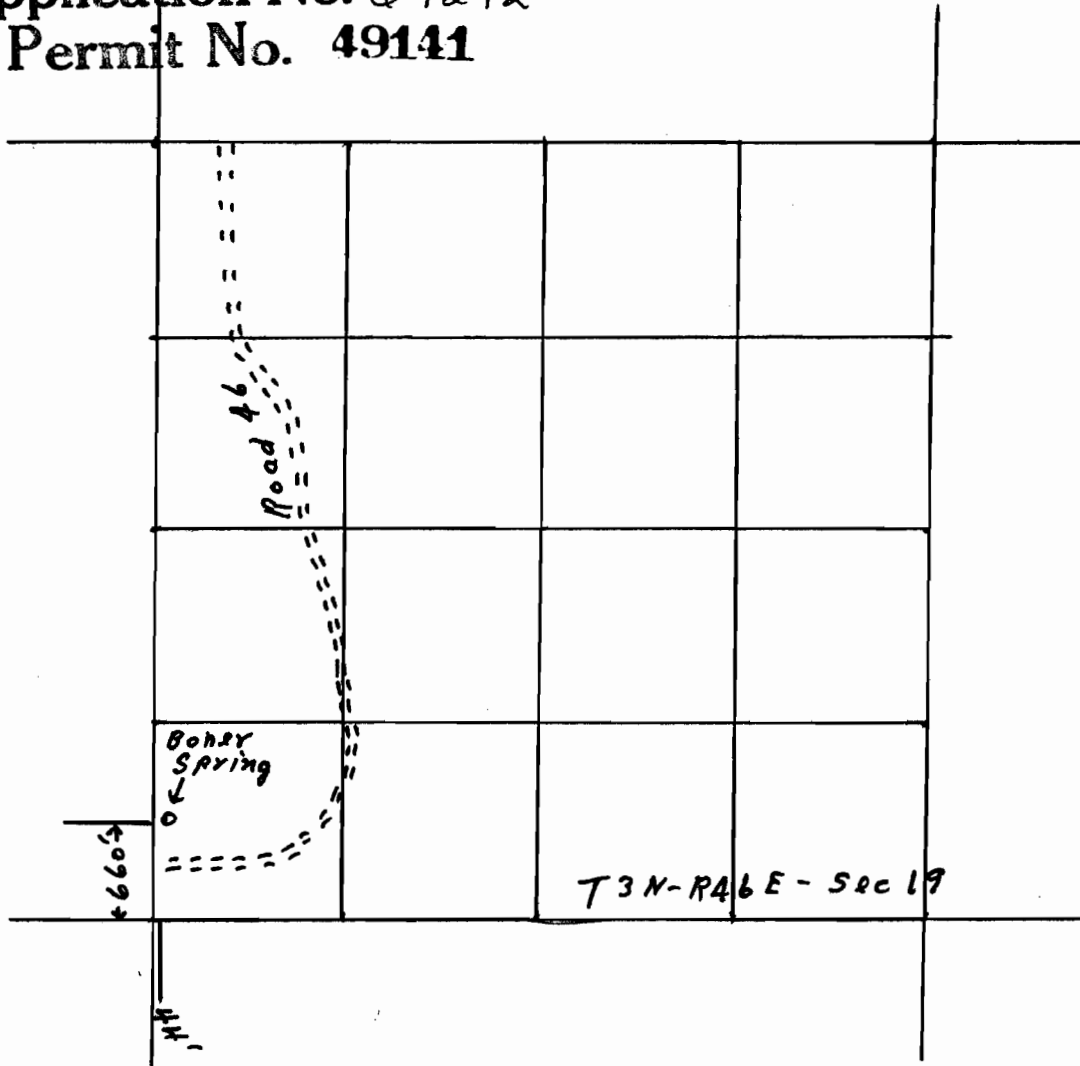

RECEIVED

SEP 30 1982

WATER RESOURCES DEPT.
SALEM, OREGON

4 inches = 1 mile