


N 9

Application No. 64275
Permit No. 49144

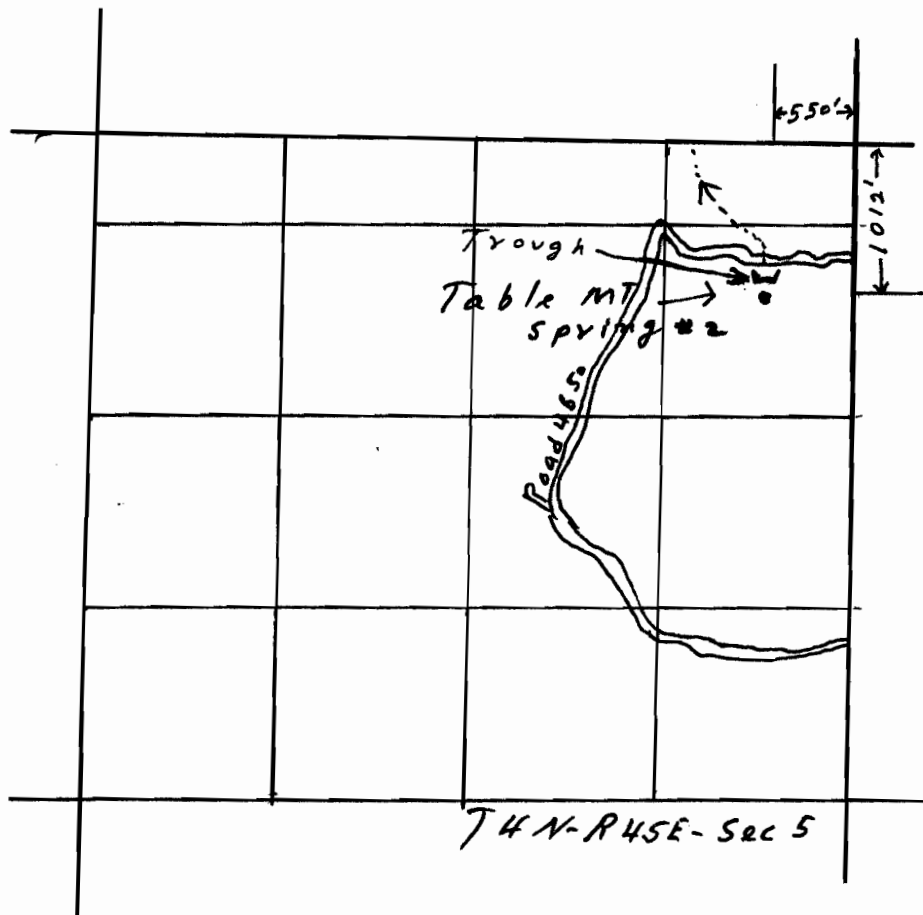

RECEIVED
SEP 30 1982
WATER RESOURCES DIV.
SALEM, OREGON

4 inches = 1 mile