


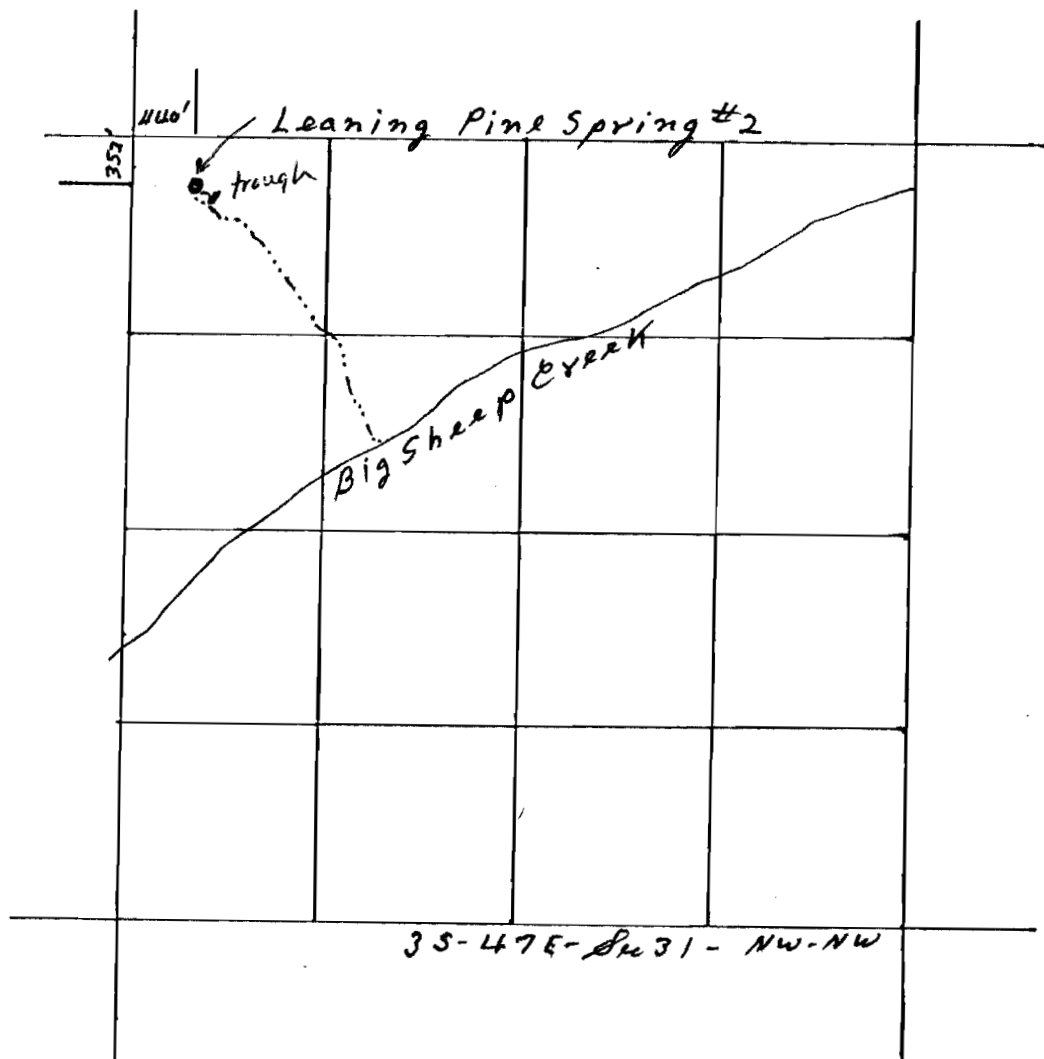

4 inches = 1 mile

RECEIVED

APR 29 1980
WATER RESOURCES DEPT
SALEM, OREGON

Application No. 65739
Permit No. 49725