




RECEIVED
APR 29 1980
W. LAND RESOURCES DEPT
SALEM, OREGON

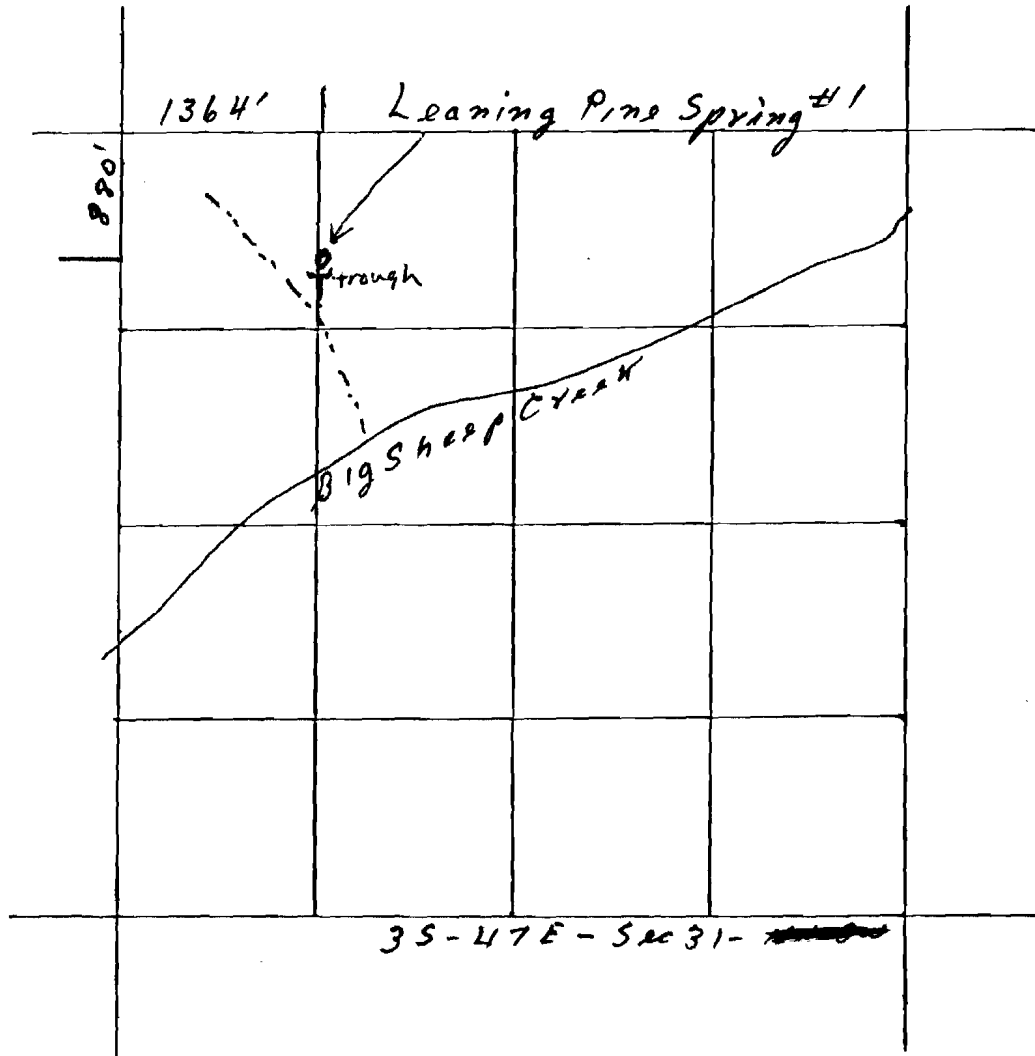

4 inches = 1 mile

Application No. 65740
Permit No. 49726