


N

RECEIVED

APR 29 1982

WATER RESOURCES DEPT
SALEM, OREGON

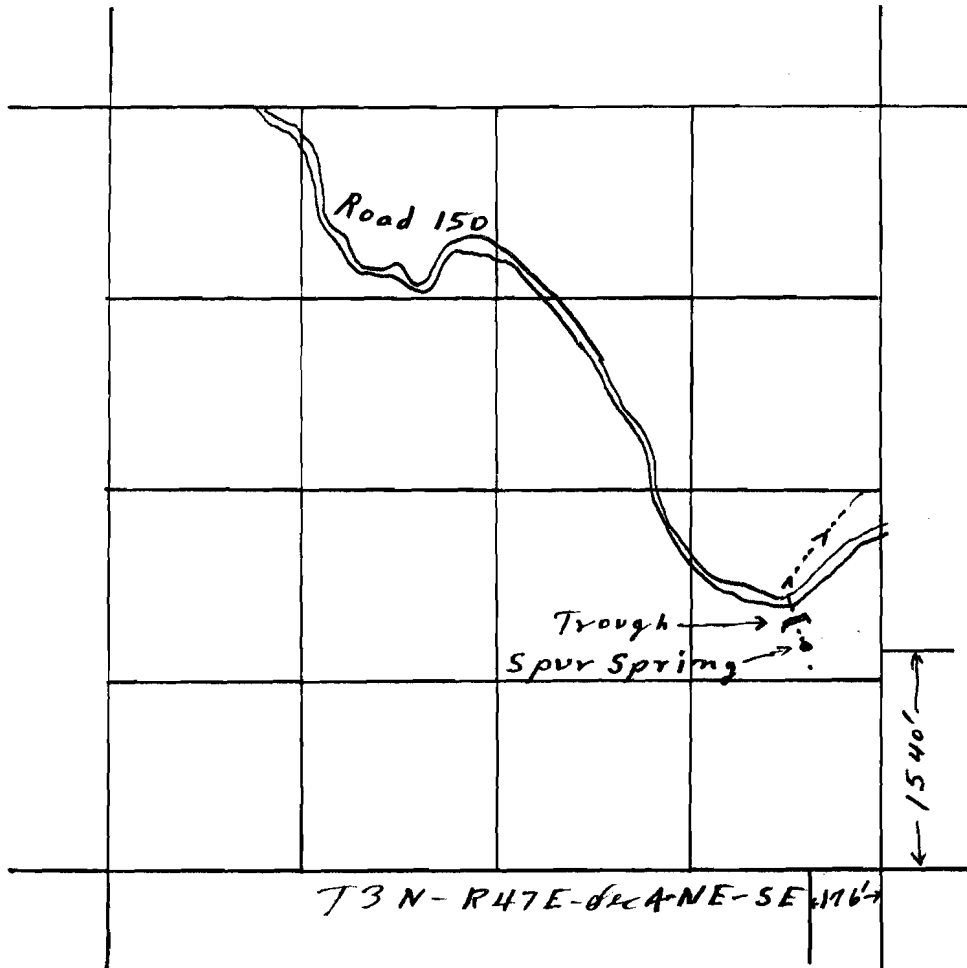

4 inches = 1 mile

Application No. 65742
Permit No. 49728