


N

RECEIVED

APR 29 1982

LAND SURFACES DEPT
SALEM, OREGON

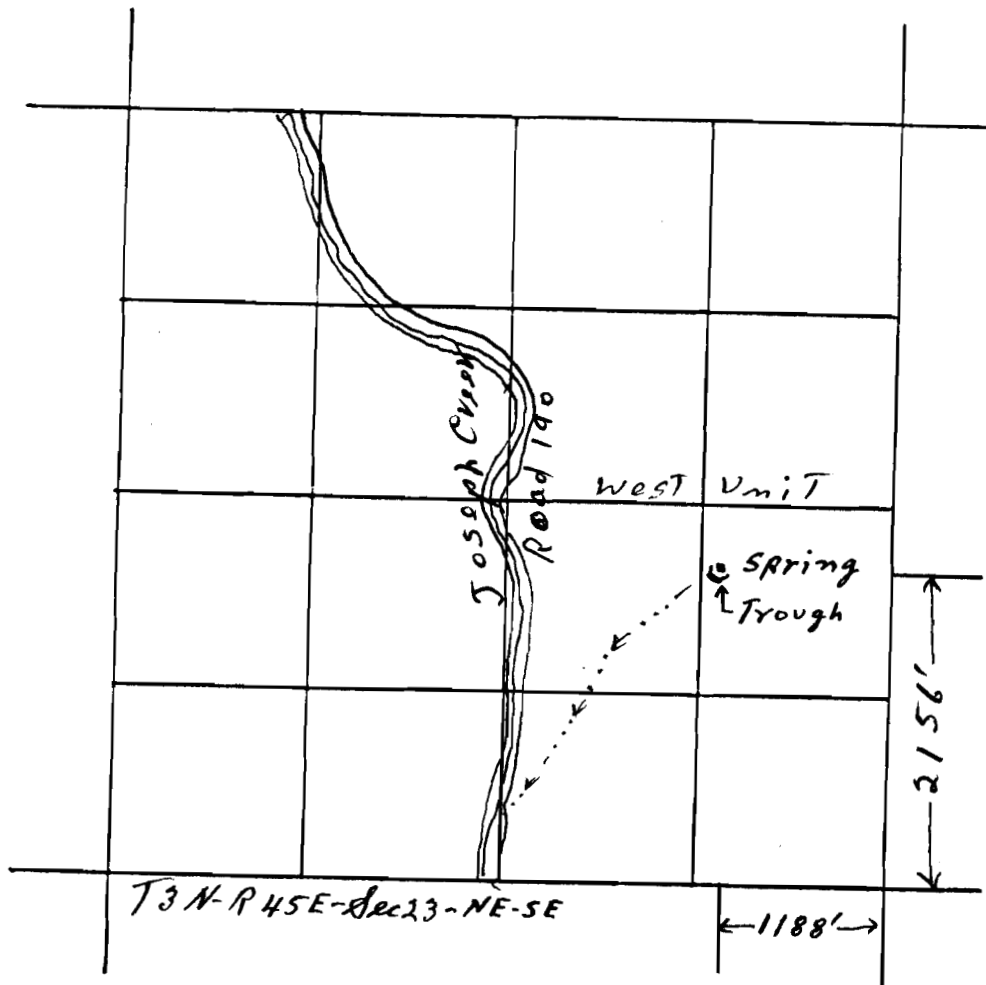

4 inches = 1 mile

Application No. 65744

Permit No. 49730