N

RECEIVED
AUG 29 2002
WATER RESOURCES DEPT
SALEM, OREGON

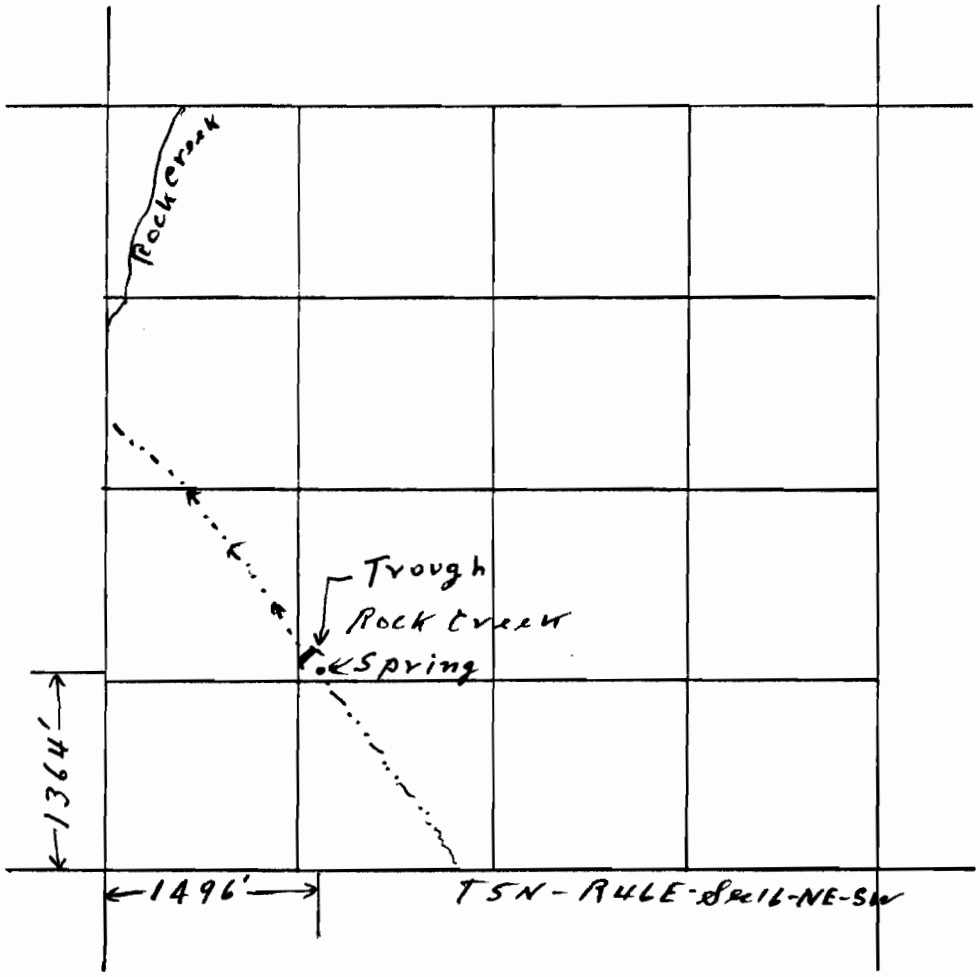

4 inches = 1 mile

Application No. 65747
Permit No. 49733