


RECEIVED
APR 29 1907
LAND REVENUE DEPT
SALEM, OREGON

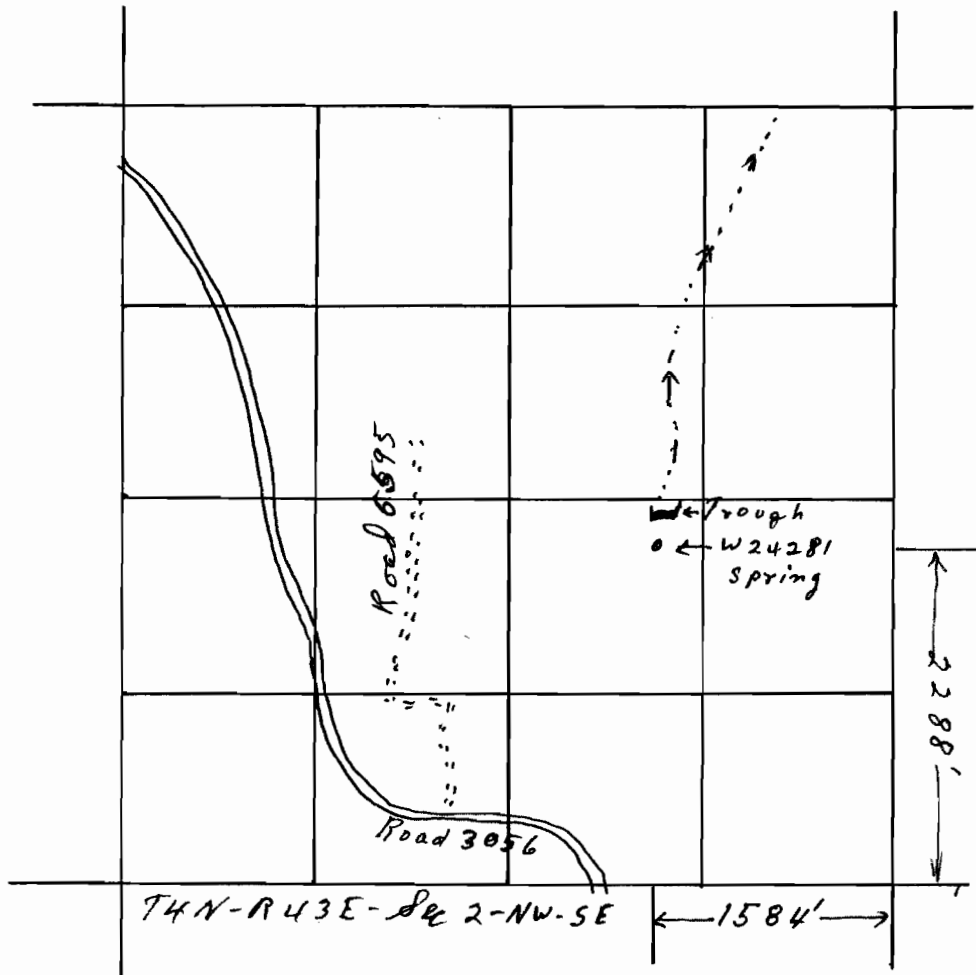

4 inches = 1 mile

Application No. 65748
Permit No. 49734