


N ↑

RECEIVED  
APR 29 1982  
COUNTY CLERK'S DEPT.  
SALEM, OREGON

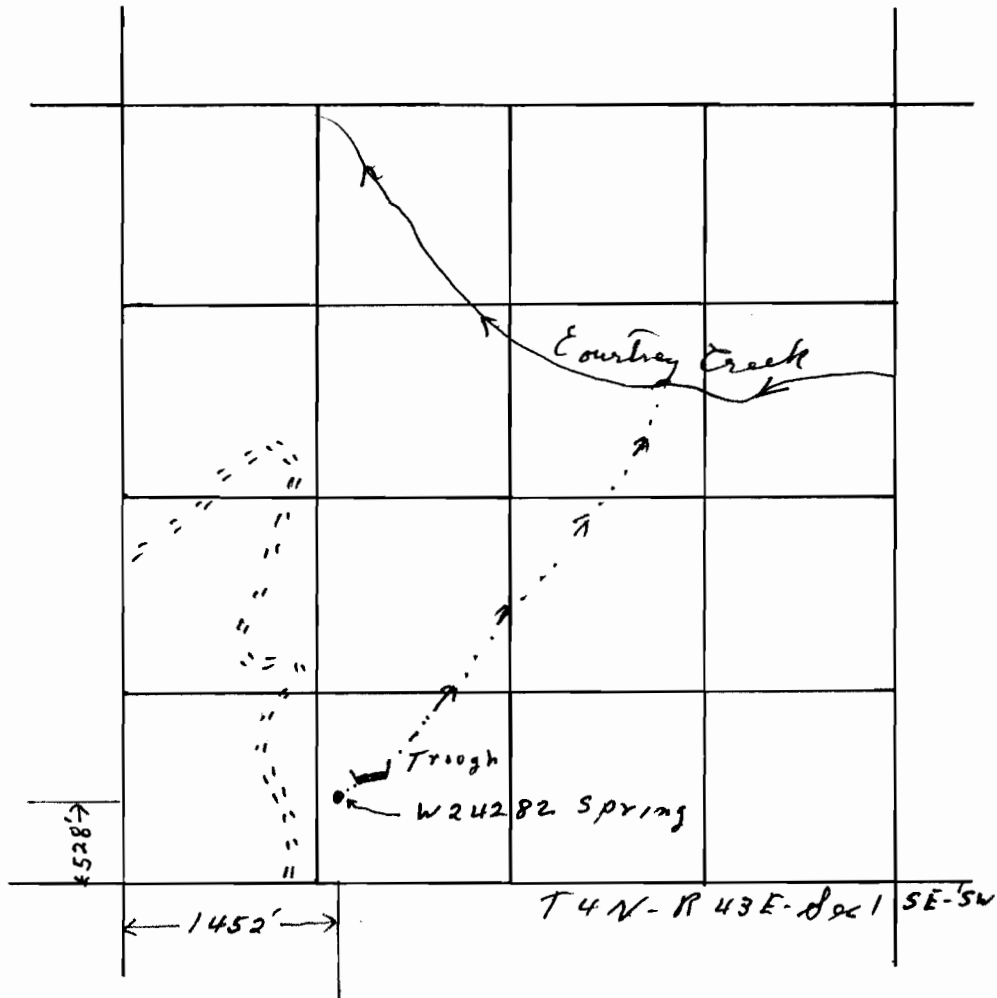

1/4 inches = 1 mile

Application No. 65753

Permit No. 49739